

MISSISSIPPI DEPARTMENT OF NATURAL RESOURCES

Bureau of Land and Water Resources

Southport Mall

P.O. Box 10631

Jackson, Mississippi 39209 **CODED**

WATER WELL DRILLERS LOG

Senflower  
KH88  
4/15/82  
6047

4/15 19 82 Dyer Well Senflower  
date well completed firm name county well located

LANDOWNER: Buddy Grant

description of formations encountered from to

(mailing address)

Clay	0	28
Fine Sand	28	40
Sand	40	48
Sand & Gravel	48	110

WELL LOCATION:  
sec 27-T-21 N R 3 E  
2 miles SE of Dodderville  
(distance) (direction) (nearest town)

WELL PURPOSE:  
(home, irrigation, municipal, industrial)

WELL COMPLETION DATA:

- (1) diameter (inches) 16
- (2) total depth (feet) 110
- (3) static water level (feet) 18 below above top of ground.
- (4) casing Steel 110  
(material) (depth)  
16 if telescope see back.  
(size)
- (5) screen 40 70  
(length) (depth to top)  
16 mild steel  
(size) (material)
- (6) pump 40 2000  
(HP) (yield gpm)  
electric  
(type power)
- (7) electric log No  
(yes or no)  
(organization running log)
- (8) how well bottom plugged flat


DRILLERS REMARKS:

DEPT. OF NATURAL RESOURCES  
BUREAU OF LAND & WATER RESOURCES

SEP 30 1982  
**RECEIVED**

If well telescopes please sketch and show depths.

GROUND LEVEL

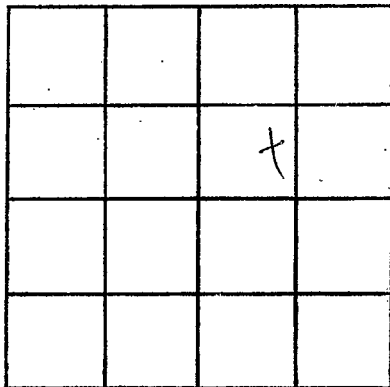

SECTION 27

Please indicate well location X.

ADDITIONAL INFORMATION

If more than one screen,  
show locations of each on sketch.