

MISSISSIPPI DEPARTMENT OF NATURAL RESOURCES
Bureau of Land and Water Resources
 Southport Mall
 P.O. Box 10631
 Jackson, Mississippi 39209
WATER WELL DRILLERS LOG

CODED

Sunflower
A 91
5/3/82

5-3 19 82 Dyer Well Sunflower
 date well completed firm name county well located

LANDOWNER: LD McCoy

description of formations encountered

(mailing address)

description of formations encountered	from	to
<u>C. clay</u>	<u>0</u>	<u>24</u>
<u>fine sand</u>	<u>24</u>	<u>39</u>
<u>sand</u>	<u>39</u>	<u>45</u>
<u>Small + Gravel</u>	<u>45</u>	<u>103</u>

WELL LOCATION:
 sec. 27 T 26 N R 3 E
2 miles E of Dodderville
 (distance) (direction) (nearest town)

WELL PURPOSE:
 (home, irrigation, municipal, industrial)

WELL COMPLETION DATA:

- (1) diameter (inches) 12"
- (2) total depth (feet) 103
- (3) static water level (feet) 18 below above top of ground.
- (4) casing Steel, 80-63
 (material) (depth)
12 If telescope see back.
 (size)
- (5) screen 40, 63
 (length) (depth to top)
12, Mild Steel
 (size) (material)
- (6) pump 40, 2500
 (HP) (yield gpm)
Electric
 (type power)
- (7) electric log No
 (yes or no)

(organization running log)

(8) how well bottom plugged plate


DRILLERS REMARKS:

DEPT. OF NATURAL RESOURCES
 BUREAU OF LAND & WATER RESOURCES

SEP 30 1982
RECEIVED

If well telescopes please sketch and show depths.

GROUND LEVEL

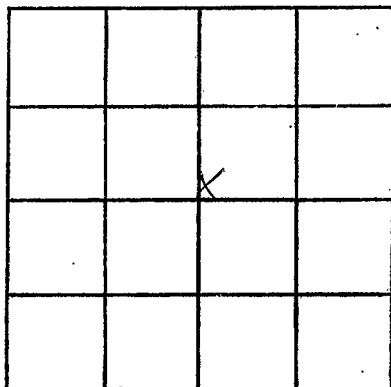

SECTION 27

Please indicate well location X.

ADDITIONAL INFORMATION

If more than one screen, show locations of each on sketch.