

MISSISSIPPI DEPARTMENT OF NATURAL RESOURCES

Bureau of Land and Water Resources

Southport Mall

P.O. Box 10631

Jackson, Mississippi 39209

WATER WELL DRILLERS LOG

CODED

Sunflower
H 92
415182

4-15 1982 Open well Sunflower
 date well completed firm name county well located

LANDOWNER: Nuber
 (mailing address)

description of formations encountered	from	to
<u>Clay</u>	<u>0</u>	<u>25</u>
<u>fine sand</u>	<u>25</u>	<u>55</u>
<u>sand & gravel</u>	<u>55</u>	<u>108</u>

WELL LOCATION:
 sec. 36 T 21 N R 3 E
4 miles E of Doddsville
 (distance) (direction) (nearest town)

WELL PURPOSE:
 (home, irrigation, municipal, industrial)

- WELL COMPLETION DATA:
- (1) diameter (inches) 16
 - (2) total depth (feet) 108
 - (3) static water level (feet) 18 below top of ground.
 - (4) casing Steel 68
 (material) (depth)
 - 16 if telescope see back.
 (size)
 - (5) screen 40 68
 (length) (depth to top)
 - 16 mild steel
 (size) (material)
 - (6) pump 60 3000
 (HP) (yield gpm)
 - diesel
 (type power)
 - (7) electric log No
 (yes or no)
 - (organization running log)
 - (8) how well bottom plugged Plate


DRILLERS REMARKS:

DEPT. OF NATURAL RESOURCES
 BUREAU OF LAND & WATER RESOURCES

SEP 30 1982
 RECEIVED

If well telescopes please sketch and show depths.

GROUND LEVEL

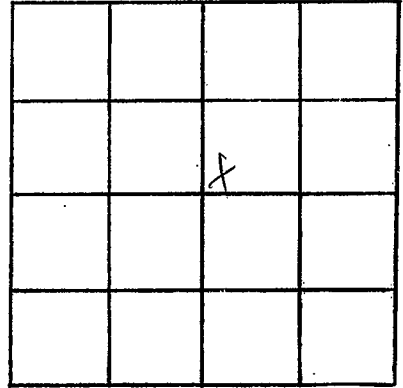

SECTION 36

Please indicate well location X.

ADDITIONAL INFORMATION

If more than one screen, show locations of each on sketch.