

MISSISSIPPI DEPARTMENT OF NATURAL RESOURCES

Bureau of Land and Water Resources

Southport Mall

P.O. Box 10631

Jackson, Mississippi 39209

WATER WELL DRILLERS LOG

CODED

Sunflower
H 94
5/18/82

GW 10574

NW/NE, Sec. 18

Elev. 130

5-18-82
 date well completed

Oger Well
 firm name

Sunflower
 county well located

LANDOWNER: *Tobin Farm*

description of formations encountered

from

to

(mailing address)

WELL LOCATION:

sec. 18 T. 21 N. R. 3 E
3 miles N of Dockleville
 (distance) (direction) (nearest town)

WELL PURPOSE:

(home, irrigation, municipal, industrial)

WELL COMPLETION DATA:

- (1) diameter (inches) 16
- (2) total depth (feet) 108
- (3) static water level (feet) 15 below above top of ground.
- (4) casing Steel, 108, 68
 (material) (depth)
16 If telescope see back.
 (size)
- (5) screen 40, 68
 (length) (depth to top)
16, Mild Steel
 (size) (material)
- (6) pump 40, 2,000
 (HP) (yield gpm)
diesel
 (type power)
- (7) electric log No
 (yes or no)

(organization running log)

(8) how well bottom plugged Plate

DRILLERS REMARKS:


DEPT. OF NATURAL RESOURCES
 BUREAU OF LAND & WATER RESOURCES

SEP 30 1982

RECEIVED

If well telescopes please sketch and show depths.

GROUND LEVEL

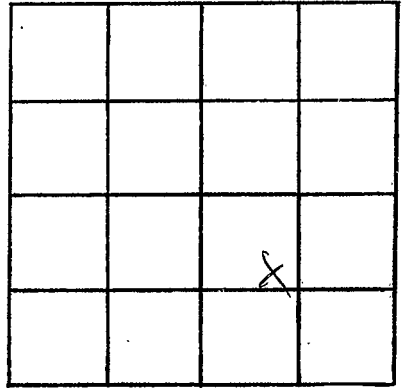

SECTION 18

Please indicate well location X.

ADDITIONAL INFORMATION

If more than one screen,
show locations of each on sketch.