

MISSISSIPPI DEPARTMENT OF NATURAL RESOURCES

Bureau of Land and Water Resources

Southport Mall

P.O. Box 10631

Jackson, Mississippi 39209

CODED

WATER WELL DRILLERS LOG

Shuford
~~82-2242~~
 H 95
 8/4/82

8-4 1982 *Layne-Central Co.* *Shuford*
 date well completed firm name county well located

LANDOWNER:	description of formations encountered	from	to
<i>Hewitt Corporation</i>			
<i>Greenwood, Ms</i> (mailing address)	<i>coarse sand</i>	<i>24</i>	<i>48</i>
WELL LOCATION: #3	<i>coarse sand & peagravel</i>	<i>48</i>	<i>85</i>
sec. <i>5</i> T <i>21</i> (N) R <i>3</i> E S W	<i>Coarse sand + gravel</i>	<i>85</i>	<i>101</i>
<i>2</i> miles <i>SE</i> of <i>Rulerille</i> (distance) (direction) (nearest town)			
WELL PURPOSE: (home, irrigation, municipal, industrial)			
WELL COMPLETION DATA:			
(1) diameter (inches) <i>20"</i>			
(2) total depth (feet) <i>98'</i>			
(3) static water level (feet) <i>25'</i> below above top of ground.			
(4) casing <i>PVC</i> <i>58'</i> (material) (depth)			
<i>8"</i> if telescope see back. (size)			
(5) screen <i>40'</i> <i>58'</i> (length) (depth to top)			
<i>8"</i> <i>PVC</i> (size) (material)			
(6) pump <i>15</i> <i>800</i> (HP) (yield gpm)			
<i>electric</i> (type power)			
(7) electric log <i>No</i> (yes or no)			
(organization running log)			
(8) how well bottom plugged <i>Cap</i>			
DRILLERS REMARKS:			


DEPT. OF NATURAL RESOURCES
 BUREAU OF LAND & WATER RESOURCES

DEC - 6 1982

RECEIVED

If well telescopes please
sketch and show depths.

GROUND LEVEL

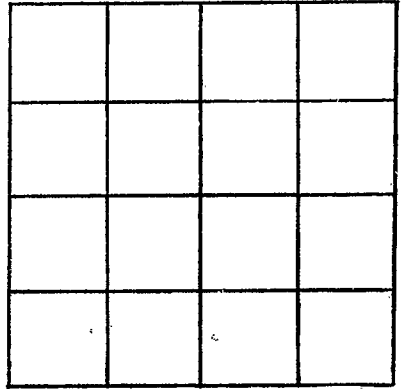

SECTION _____

Please indicate well location X.

ADDITIONAL INFORMATION

If more than one screen,
show locations of each on sketch.