

MISSISSIPPI DEPARTMENT OF NATURAL RESOURCES

Bureau of Land and Water Resources

Southport Mall

P.O. Box 10631

Jackson, Mississippi 39209

WATER WELL DRILLERS LOG CODED

SUNFLOWER  
H 97  
4/21/83

GW 10576

SW/NE, Sec. 7

Elev. 125

John Patton Chesno

4-21-83

19

Irrigation Equipment, Inc.

firm name

Sunflower

county well located

LANDOWNER: Cottondale Farms

P. O. Box 926

Averdeen, MS 39730

(mailing address)

WELL LOCATION:

7-8-21 sec. T N R 3 E S W  
6 miles West of Glendora  
(distance) (direction) (nearest town)

WELL PURPOSE: Irrigation  
(home, irrigation, municipal, industrial)

WELL COMPLETION DATA:

- (1) diameter (inches) 16
- (2) total depth (feet) 110
- (3) static water level (feet) 35 below above top of ground.
- (4) casing steel, 70',  
(material) (depth)  
16" if telescope see back.  
(size)
- (5) screen 40', 70', 110'  
(length) (depth to top)  
16", steel  
(size) (material)
- (6) pump 60 1600  
(HP) (yield gpm)  
diesel  
(type power)
- (7) electric log \_\_\_\_\_  
(yes or no)  
\_\_\_\_\_  
(organization running log)

(8) how well bottom plugged \_\_\_\_\_  
steel plate

DRILLERS REMARKS:

description of formations encountered	from	to
Brown clay	0	25
Blue clay	25	65
Coarse sand	65	90
Coarse sand & gravel	90	110

CODED


DEPT. OF NATURAL RESOURCES  
BUREAU OF LAND & WATER RESOURCES

MAY 20 1983

RECEIVED

If well telescopes please sketch and show depths.

GROUND LEVEL

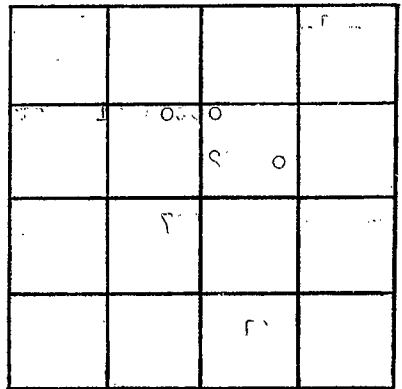

SECTION \_\_\_\_\_

Please indicate well location X.

ADDITIONAL INFORMATION

If more than one screen, show locations of each on sketch.