

MISSISSIPPI DEPARTMENT OF NATURAL RESOURCES

Bureau of Land and Water Resources

Southport Mall

P.O. Box 10631

Jackson, Mississippi 39209

WATER WELL DRILLERS LOG

CODED

SUNFLOWER
H.98
426183

John Patton Chism
Irrigation Equipment, Inc.

Sunflower

4-26-83

date well completed


firm name

county well located

LANDOWNER: <u>Cottdonale Farms</u> <u>P. O. Box 926</u>	description of formations encountered	from	to
<u>Averdean, MS 39730</u> (mailing address)	<u>Brown clay</u>	<u>0</u>	<u>25</u>
	<u>Blue clay</u>	<u>25</u>	<u>60</u>
	<u>Coarse sand</u>	<u>60</u>	<u>80</u>
WELL LOCATION: sec. <u>8</u> T. <u>21</u> N. R. <u>3</u> E <u>6</u> miles West <u>Glendora</u> (distance) (direction) of (nearest town)	<u>Coarse sand & gravel</u>	<u>80</u>	<u>110</u>
WELL PURPOSE: (home, irrigation, municipal, industrial)	CODED		
WELL COMPLETION DATA:			
(1) diameter (inches) <u>16</u>			
(2) total depth (feet) <u>110</u>			
(3) static water level (feet) <u>35</u> below above top of ground.			
(4) casing <u>steel</u> , <u>70'</u> (material) (depth) <u>16"</u> if telescope see back. (size)			
(5) screen <u>40'</u> , <u>70'-110'</u> (length) (depth to top)			
(6) pump <u>80</u> , <u>1400</u> (HP) (yield gpm)			
(7) electric log <u>diesel</u> (type power)			
(8) electric log (yes or no) (organization running log)		DEPT. OF NATURAL RESOURCES BUREAU OF LAND & WATER RESOURCES MAY 20 1983	
(8) how well bottom plugged	RECEIVED		
DRILLERS REMARKS:			

If well telescopes please sketch and show depths.

GROUND LEVEL

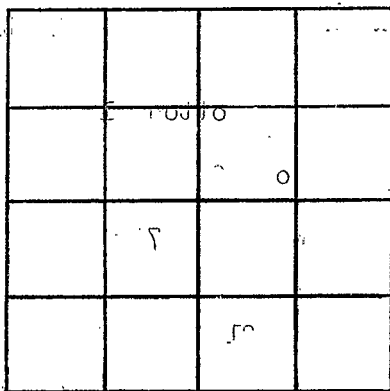

SECTION _____

Please indicate well location X.

ADDITIONAL INFORMATION

If more than one screen, show locations of each on sketch.