

SUNFLOWER

H 100

6-25-68

MISSISSIPPI
BOARD OF WATER COMMISSIONERS
416 North State Street
Jackson, Mississippi 39201

CODED

WATER WELL DRILLERS LOG

6-25
date well completed1968 DYER WELL & IR. SANFLOWER
firm name county well located

LANDOWNER:

TRANS PARCER Co

description of formations
encountered

from

to

DROW,

(mailing address)

CLAY

0 16

FINE GRAY SAND

16 24

MED. SAND

24 38

BLUE CLAY

38 43

MED. SAND

43 52

COARSE SAND & GRA.

52 105

WELL LOCATION:

sec. 17 T 21 N R 3 E W
2 1/2 miles S.E. of RENEVILLE
(distance) (direction) (nearest town)

WELL PURPOSE:


(home, irrigation, municipal, industrial)

WELL COMPLETION DATA:

- (1) diameter (inches) 12"
(2) total depth (feet) 103'
(3) static water level (feet) 21' below
top of ground.
(4) casing BUC IR, 71'
(material) (depth)
12" if telescope see back.
(size)
(5) screen 32', 71'
(length) (depth to top)
12" BUC IR
(size) (material)
(6) pump 28 1500
(HP) (yield gpm)
DIESEL
(type power)
(7) electric log x/d
(yes or no)
(organization running log)
(8) how well bottom plugged NOTE


DRILLERS REMARKS:

CODED

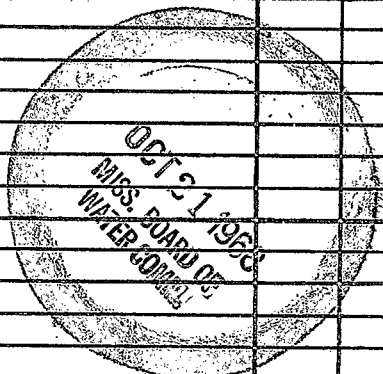

If well telescopes please
sketch and show depths.

GROUND LEVEL

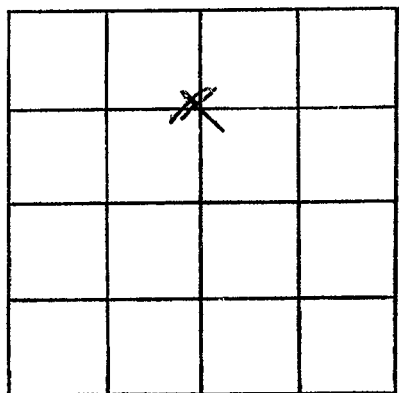

SECTION 17

Please indicate well location X.

ADDITIONAL INFORMATION

If more than one screen,
show locations of each on sketch.