

SUNFLOWER
 CL-2607
 H101

MISSISSIPPI DEPARTMENT OF NATURAL RESOURCES
 Bureau of Land and Water Resources
 Southport Mall
 P.O. Box 10631
 Jackson, Mississippi 39209
WATER WELL DRILLERS LOG

CODED

3-25 19 84 LAYNE-CENTRAL CO. SUNFLOWER
 date well completed firm name county well located

LANDOWNER:
 SUNFLOWER ENTERPRISES
 DODDSVILLE, MS
 (mailing address)

description of formations encountered	from	to
clay	0	35
coarse sand	35	45
coarse sand/gravel	45	107
sand rock	107	108
fine sand	108	114

WELL LOCATION: # a of 4
 sec. 24 T 21 (N) R 3 E
 Barnett place (W)
 6 miles sw of Doddsville
 (distance) (direction) (nearest town)

WELL PURPOSE: irrigation
 (home, irrigation, municipal, industrial)

WELL COMPLETION DATA:

- (1) diameter (inches) 28"
- (2) total depth (feet) 105'
- (3) static water level (feet) 29' 9" below top of ground.
- (4) casing steel 65' (material), (depth)
 12" (size) if telescope see back.
- (5) screen 40' 65' (length), (depth to top)
 12" st. steel (size), (material)
- (6) pump 40 700 (HP), (yield gpm)
 gear drive (type power)
- (7) electric log no (yes or no)
 (organization running log) st. plate
- (8) how well bottom plugged

CODED

DEPT. OF NATURAL RESOURCES
 BUREAU OF LAND & WATER RESOURCES


OCT 29 1984

RECEIVED

DRILLERS REMARKS:

If well telescopes please sketch and show depths.

GROUND LEVEL

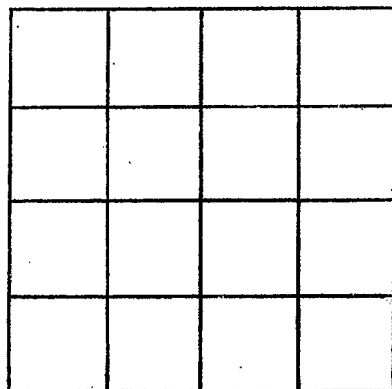

SECTION _____

Please indicate well location X.

ADDITIONAL INFORMATION

If more than one screen,
show locations of each on sketch.