

MISSISSIPPI DEPARTMENT OF NATURAL RESOURCES  
 Bureau of Land and Water Resources  
 Southport Mall  
 P.O. Box 10631  
 Jackson, Mississippi 39209  
**WATER WELL DRILLERS LOG**

CODED

SUNFLOWER  
H 102

~~J K Irrigation~~ JK Irrigation 19 86 J K Irrigation SUNFLOWER  
 date well completed firm name county well located

LANDOWNER: D. B. McCarty

description of formations encountered from to

(mailing address)

CLAY 0 38  
FINE SAND 38 44  
SAND Gravel 44 110

WELL LOCATION:  
 sec. 21 T. 21 (N) S R. 3 (W) E  
2 miles E of Doddsville  
 (distance) (direction) (nearest town)

WELL PURPOSE:  
 (home, irrigation, municipal, industrial)

WELL COMPLETION DATA:


- diameter (inches) 16"
- total depth (feet) 110
- static water level (feet) 20 below above top of ground.
- casing Steel, 70 (material) (depth)  
16 if telescope see back. (size)
- screen 40, 970 (length) (depth to top)  
 (size) (material)
- pump 30, 1500 (HP) (yield gpm)  
Electric! (type power)
- electric log no (yes or no)

(organization running log)

(8) how well bottom plugged CAP

DRILLERS REMARKS:

CODED

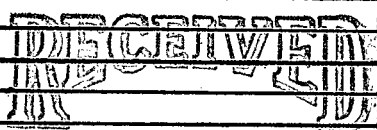


MAY 20 1986

Department of Natural Resources  
 Bureau of Land & Water Resources

If well telescopes please  
sketch and show depths.

GROUND LEVEL

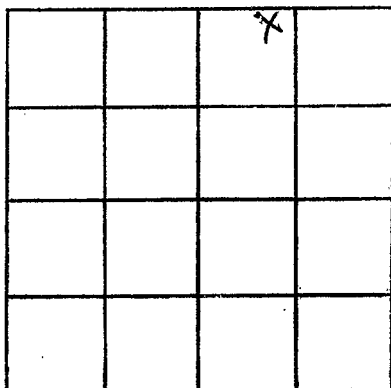

SECTION 21

Please indicate well location X.

ADDITIONAL INFORMATION

If more than one screen,  
show locations of each on sketch.