

MISSISSIPPI DEPARTMENT OF NATURAL RESOURCES
Bureau of Land and Water Resources
 Southport Mall
 P.O. Box 10631
 Jackson, Mississippi 39209
WATER WELL DRILLERS LOG

CODED

Sunflower
H 103

5/24 1986 Job K Irrigation Sunflower
 date well completed firm name county well located

LANDOWNER: Bertrice Taylor

description of formations encountered

from to

(mailing address)

WELL LOCATION:

sec. 9 T. 21 N. R. 3 W.
3 1/2 miles S of Rullyville
 (distance) (direction) (nearest town)

WELL PURPOSE:

(home, irrigation, municipal, industrial)

WELL COMPLETION DATA:

- (1) diameter (inches) 10
- (2) total depth (feet) 117
- (3) static water level (feet) 24 below above top of ground.
- (4) casing PVC, 77,
 (material) (depth)
10 if telescope see back.
 (size)
- (5) screen 40, PVC
 (length) (depth to top)
10 (size) (material)
- (6) pump 15 (HP), 900 (yield gpm)
Electric
 (type power)
- (7) electric log NO
 (yes or no)


(organization running log)

(8) how well bottom plugged CAP

DRILLERS REMARKS:

<u>CLAY</u>	<u>0</u>	<u>24</u>
<u>FINE SAND</u>	<u>24</u>	<u>36</u>
<u>SAND GRAVEL</u>	<u>38</u>	<u>117</u>

CODED

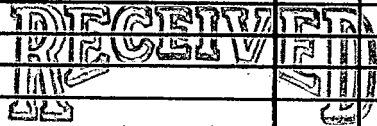


MAY 29 1986

Department of Natural Resources
 Bureau of Land & Water Resources

If well telescopes please
sketch and show depths.

GROUND LEVEL

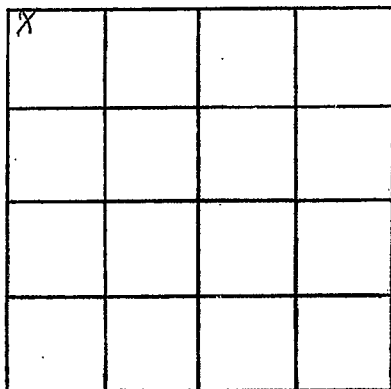

SECTION 9

Please indicate well location X.

ADDITIONAL INFORMATION

If more than one screen,
show locations of each on sketch.