

MISSISSIPPI DEPARTMENT OF NATURAL RESOURCES

Bureau of Land and Water Resources

Southport Mall

P.O. Box 10631

Jackson, Mississippi 39209

WATER WELL DRILLERS LOG

BUTANE GAS CO. OF GREENWOOD

CODED

Sunflower

7-21
date well completed

firm name

county well located

LANDOWNER:

description of formations
encountered

from

to

TRAVELERS INS. CO.

CLAY

0 25

(mailing address)

SAND

25 40

SAND + PER GRAVEL

40 55

GRAVEL

55 95

WELL LOCATION:

sec. 12 T 21 N R 3 E
S W5 1/2 miles SE of Ruleville
(distance) (direction) (nearest town)

CODED

WELL PURPOSE:

(home, irrigation, municipal, industrial)

WELL COMPLETION DATA:

- (1) diameter (inches) 16"
- (2) total depth (feet) 95
- (3) static water level (feet) 23 below top of ground.

Permit #

- (4) casing Steel, 55"
(material) (depth)

MS-GW-02950

16" If telescope see back.
(size)

- (5) screen 40, 55
(length) (depth to top)

16" Steel
(size) (material)

- (6) pump 40 2000
(HP) (yield gpm)

Elec.
(type power)

- (7) electric log NO
(yes or no)

(organization running log)

- (8) how well bottom plugged
Steel Plate

DRILLERS REMARKS:


RECEIVED

AUG 12 1986

Department of Natural Resources
Bureau of Land & Water Resources

If well telescopes please
sketch and show depths.

GROUND LEVEL

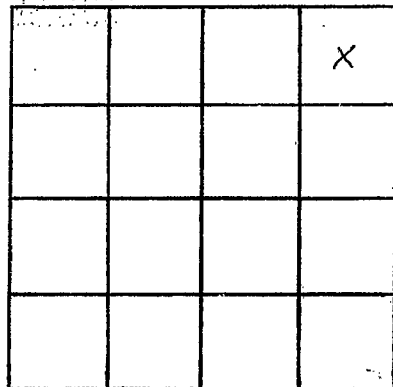

SECTION 12

Please indicate well location X.

ADDITIONAL INFORMATION

If more than one screen,
show locations of each on sketch.