

MISSISSIPPI DEPARTMENT OF NATURAL RESOURCES

Bureau of Land and Water Resources

Southport Mall

P.O. Box 10631

Jackson, Mississippi 39209

CODED

WATER WELL DRILLERS LOG

HW107
 SYN FLOWER
 6-31-83

GW 10627

NE 1 SW, Sec. 30

Elev. 129

June 31 1983 Della Well & Supply Sumner
 (date well completed) firm name county well located

LANDOWNER: Fischer, Tom Service
Aurdeen Mrs.
 (mailing address)

description of formations encountered	from	to
<u>Top soil</u>	<u>0</u>	<u>21</u>
<u>sand</u>	<u>21</u>	<u>40</u>
<u>course sand & Pen gravel</u>	<u>40</u>	<u>105</u>

WELL LOCATION:
 sec. 30 T 21 N, R 3 E
8 S W
2 miles West of Doddsville
 (distance) (direction) (nearest town)

WELL PURPOSE: Domestic
 (home, irrigation, municipal, industrial)

WELL COMPLETION DATA:

(1) diameter (inches) 16"

(2) total depth (feet) 105

(3) static water level (feet) 30 below above top of ground.

(4) casing Steel (material), (depth) _____
 _____ if telescope see back. (size)

(5) screen 40 (length), (depth to top) _____
16" (size), Steel (material)

(6) pump 71 (HP), 1070 (yield gpm)
Disc (type power)

(7) electric log no (yes or no)
 _____ (organization running log)

(8) how well bottom plugged Steel Plat

CODED

DEPT. OF NATURAL RESOURCES
 BUREAU OF LAND & WATER RESOURCES

AUG 5 1983

RECEIVED

DRILLERS REMARKS: _____

If well telescopes please sketch and show depths.


GROUND LEVEL

Water Panel 30'

16" casing
Steel

4" x 16"
Screen

If more than one screen,
show locations of each on sketch.

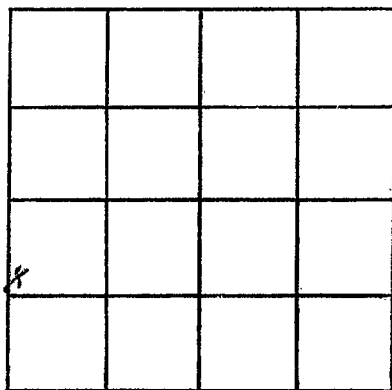

SECTION 3

Please indicate well location X.

ADDITIONAL INFORMATION

Lined area for additional information.