	state w	en Keport	
County: Sunflower	Part 1 For Office Use		For Office Use Only:
Permit #:6W-39745	# · · · · · · · · · · · · · · · · · · ·		Aquifer:
Irrigation Equipment	Office of Land and Water Resources		Well #: H 147
l Deillen	1.0.20010031		
Date drilling completed: 7-28-04		961-5210	L. S. Elevation:
		1-6938 (fax)	E-log #:
State Law requires that this rep		driller in detail and filed w	rith the Department within
30 days of completion of drilling Well Owner Information		\$17_1	Location
0-443-1	arron	_	
Owner Name Cottondale		Latitude: 23 • 41 , 2	" Longitude: 90 · 32 · 36 "
Mailing Address:	Farm Services	Method of Lat/Long (circle or	ne): Conventional Survey,
Box 926		USGS quad, Hand-held	GPS, Survey-grade GPS
Aberdeen, MS	39730	7	Twn_21N Rng ^{3W}
City Sta	ate Zip Code	¼¼ Sec	Iwn Rng
Telephone No. (662) 369-9531		Distance Direction Miles South	Nearest Town of_Ruleville
	Well I		
		Ala	Irrigation Replacement
Purpose of Well (circle one) Home Inc		Irrigation Fish Culture	Other:
Date well drilling started: $7-28-0$	Date v	well drilling completed: 7	-28-04
If flowing, method of flow regulation: Va	_		
Static Water Level: 41ft. feet al	bove of below (circle one) l	and surface Date measured:	7-29-04
Method of Measurement (circle one)	teel tape electric tape	air line other:	
Hole depth: 126' Well de		· · · · · · · · · · · · · · · · · · ·	10
Hole depth: Well de	pth:	Well grouted to a depth of _	feet
Type of grout (circle one): Cement Bentonite Mix			
Casing length: 86 feet Casi	ng diameter: 16	inches Type of casing:	PVC Sch.40
Screen length: 40 feet Screen diameter: 16 inches Type of screen: PVC Sch. 40			
Screen slot size:	Setting depth: From _	. 87feet to1	26 feet
Type of completion (circle all applicable): Gravel packe Underreamed Telescoped Open hole Natural Development			
Other (describe):			
Top of lap pipe or reduction in casing:feet. If telescoped or more than one screen, describe on back of page			
Logs run (circle all applicable): No log run Electric Gamma Ray Density Sonic Neutron Other:			

Name of organization running log(s):

I certify that the well was drilled, constructed, and completed in accordance with all applicable requirements of the Mississippi

0695

Department of Environmental Quality and/or the Mississippi Department of Health regulations and state laws.

Irrigation Equipment Inc. Patrick M. Chism

Print Name of Water Well Contractor and License No.

RECEIVED

Signature of Water Well Contractor

AUG 1 2 2004


14-147

If well telescopes please sketch below and show depths.

Ground	Level		

Description of Formations Encountered	From	To
Clay	0	21
Fine Sand	22	35
Fine Sand/gravel	36	55
Med. Sand/gravel	56	126
		$ldsymbol{ldsymbol{ldsymbol{\sqcup}}}$
		$oxed{oxed}$
		<u> </u>
		
		$ldsymbol{\sqcup}$
		1
		lacksquare
		11
		1
		1
	1	1

If more than one screen, show location of each on sketch

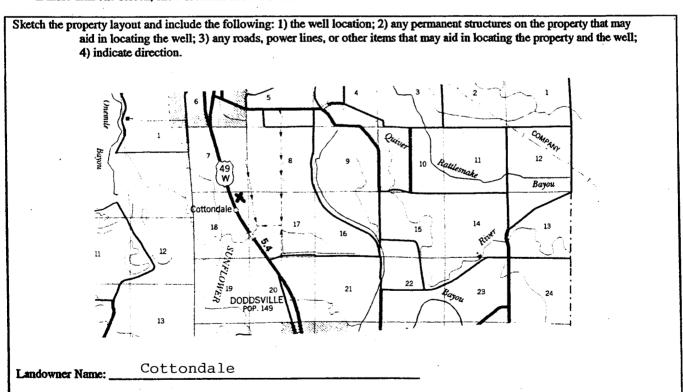

Patrick M Cham Signature of Water Well Contractor

STATE WELL REPORT

Part 2

County: Sunflower

Permit #: _____
Irrigation Equipment
Driller: _____
7-29-04

Date completed:

Pump Installer's Completion Report
Mississippi Department of Environmental Quality
Office of Land and Water Resources
P.O. Box 10631
Jackson, MS 39289-0631
(601)961-5210
(601)354-6938 (fax)

For Office Use Only:			
Aquifer:			
Well#: H147			
Elevation:			

7	Well Owner Informat	tion		Well Location	
Owner Name: C	ottondale		Latitude: 334	15 Longitude:	903236
Mailing Address: <u>C/</u>	o Fischer F	arm Services	Method of Lat/Lor	ng (circle one): Convention	onal Survey,
	x 926		USGS	quad, Hand-held GPS, S	urvey-grade GPS
Ab	erdeen, MS	39730	NE 1/2 NE	18 Twn 21	IN _{Rng} 3W
Cit	ty State	Zip Code	1		
Telephone No. (6	62-369-9531			Direction Nearest 1 South of Rules	
	Pump Type Circle one			Power Type Circle one	
Air Lift	Jet	Submersible	Diesel Engine	Gasoline Engine	Natural Gas
Bucket	Piston	Turbine	Electric Motor	Hand	Tractor PTO
Centrifugal	Rotary	Flowing Well	Windmill	Other (specify):	·
Other (specify):			Horse Power Ratin	ng of Motor: 60	
Date Pump Installed:	7-29-04			70	
	2500-3000			1	· · -
	Pump Test Data		Me	thod of Measuring Wate	r Level
Date Well Tested:	41!	Dolon I and Cuic	Air Line F	Electric Measuring Line	Steel Tape

Pump Test Data	Method of Measuring Water Level Circle one		
Static Water Level (A): Pumping Water I avel (B): Proceedings Water I avel (B): Procedings W	Air Line Electric Measuring Line Steel Tape Other (specify):		
Pumping Water Level (B):Feet Below Land Surface Drawdown [(B) - (A)]:Feet Below Land Surface	For flowing well, measured shut in head:feet		
Test Pumping Rate:Gallons Per Minute Duration of Pump Test (minimum 4 hours):hours	Well yieldedGPM with a drawdown offeet afterhours of pumping		

I HEREBY CERTIFY that the above statements are true to the best of n	ny knowledge.
Irrigation Equipment Inc. Patrick M. Chism 0695	Patrick M ChisiRECEIVED
Print Name of Pump Installer and License No. (if applicable)	Signature of Pump Installer ALIG 1 2 2004
	7 2005