County:	Sunflo	wer
Permit #	6W 400	198 Equipment
Irri@ Driller:	gation I	Equipment
Date drill	ing completed:	7-8-05

State Well Report

Part 1

Mississippi Department of Environmental Quality
Office of Land and Water Resources
P.O. Box 10631
Jackson, MS 39289-0631
(601)961-5210
(601)354-6938 (fax)

For Office Use Only:
Aquifer:
Well #: H- 158
L. S. Elevation:
E-log #:

State Law requires that this report be prepared by the driller in detail and filed with the Department within 30 days of completion of drilling of the well.

30 days of completion of drilling of the well.						
Well Owner Information	Well Location					
Owner Name Tackett Fish Farm	Latitude:°" Longitude:°"					
Mailing Address: 23939 County Road 523	Method of Lat/Long (circle one): Conventional Survey,					
	USGS quad, Hand-held GPS, Survey-grade GPS					
	NE SUL					
Schlater MS 38952	1 1 1 1 1 1 1 1 1 1 1 1 1 1 1 1 1 1 1					
City State Zip Code	Distance Direction Nearest Town					
Telephone No. ()	Miles or					
XY/ 18 X						
Schlater MS 38952 City State Zip Code Distance Direction Nearest Town SE M NW % Sec 12 Twn 21N Rng 3W Distance SE of Miles SE of Ruleville Well Data Well Data Well Data Well Circle one) Home Industrial Public Supply Irrigation Ish Culture To a see well drilling started: 7-8-05 Date well drilling completed: 7-8-05 The describe Date measured: 7-12-05 The describe Date						
Purpose of Well (circle one) Home Industrial Public Supply	Irrigation ish Culture Other. Neplacement					
Date well drilling started: 7-8-05 Date v	well drilling completed: 7-8-05					
ving, method of flow regulation: Valve Other (describe)						
Static Water Level: 53 feet above of below (circle one) l	and surface Date measured: 7-12-05					
Hole depth: 144' Well depth: 144'	Well grouted to a depth of10feet					
Type of grout (circle one): Cement Bentonie Mix						
Casing length: 104 feet Casing diameter: 16	inches Type of casing: PVC Sch. 40					
Screen length: 40 feet Screen diameter: 16	inches Type of screen: PVC Sch. 40					
Screen slot size:inches Setting depth: From _	See Backfeet tofeet					
Type of completion (circle all applicable): Gravel packed Under	reamed Telescoped Open hole Natural Development					
Other (describe):						
Top of lap pipe or reduction in casing:feet. If tel	escoped or more than one screen, describe on back of page					
Logs run (circle all applicable); no log run Electric Gamma Ray	Density Sonic Neutron Other:					
Name of organization running log(s):	· · · · · · · · · · · · · · · · · · ·					
I certify that the well was drilled, constructed, and completed in accordance with all applicable requirements of the Mississippi						
Department of Environmental Quality and/or the Mississippi Dep	partment of Health regulations and state laws.					
Irrigation Equipment Inc. Patrick M. Chism 0695	Patrick on Chiai					
Print Name of Water Well Contractor and License No.	Signature of Water Well Contractor					

RECEIVED


JUL 28 2005

BY: OLWA

Ground Level

Description of Formations Encountered	From	To
Clay	0	35
Fine Sand	36 46	45
Fine Sand Fine Sand/gravel	46	22
Med. Sand/gravel Fine Sand	153	100
Fine Sand	1197	
Med. Sand/gravel	124	44
		
	 	
	 	\vdash
97 106		1
Screen 87-106 Screen 125-144	 	1
Screen 125-144	 	
	1	
	<u> </u>	$oxed{oxed}$
	<u> </u>	

If more than one screen, show location of each on sketch

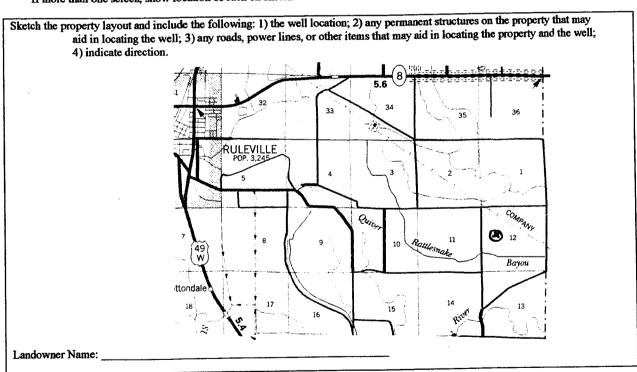

Signature of Water Well Contractor

STATE WELL REPORT

Part 2

Sunflower Pump Installer's Completion Report
Mississippi Department of Environmental Quality
Office of Land and Water Resources County: Permit#6W40498 Irrigation Equipment P.O. Box 10631 Jackson, MS 39289-0631 7-12-05 (601)961-5210

For Office Use Only:		
Aquifer:		
Well#:	H-158	
Elevation	r	

Date compacts: 7 12 03	(601)354-6938 (fax)		Elevation:	
This report should be prepared by the pump in installation of pump.	nstaller in detail and filed with the Dep	partment within 30 d	ays of the	
Well Owner Information		Well Location		
Owner Name: Tackett Fish Farm	Latitude:	Longitude:		
Mailing Address: 23939 County Road		•	•	
Schlater, MS 389 City State Zip 662-254-7322 Telephone No. ()	52 Code Distance Direct			
Pump Type Circle one		Power Type Circle one		
Air Lift Jet Submers	ible Diesel Engine (Gasoline Engine	Natural Gas	
Bucket Piston Turbine	Hectric Motor	Hand	Tractor PTO	
Centrifugal Rotary Flowing	Well Windmill	Other (specify):		
Other (specify):	Horse Power Rating of	Motor: 60		
Date Pump Installed: 7-12-05	Setting Depth:		_feet	
Rated Pump Capacity: 2500 Gallons Pe	,	2	_	
Pump Test Data	Method	of Measuring Water Circle one	Level	
Date Well Tested: Static Water Level (A): Pumping Water Level (B): Feet Below Land	Air Line Electri d Surface Other (specify):	•	•	
Drawdown [(B) - (A)]:Feet Below Lan	d Surface For flowing well, measu	ured shut in head:	feet	
Test Pumping Rate:Gallons Pe	r Minute Well yielded	Well yieldedGPM with a drawdown of		
Duration of Pump Test (minimum 4 hours):	hoursfeet a	ifter h	ours of pumping	
I HEREBY CERTIFY that the above statements are tra Patrick M. Chism 0695 Print Name of Pump Installer and License No. (if appli	Patrik N	1 Chin		

JUL 28 2005 BY: OLWR