

MISSISSIPPI DEPARTMENT OF NATURAL RESOURCES
 Bureau of Land and Water Resources
 Southport Mall
 P.O. Box 10631
 Jackson, Mississippi 39209
WATER WELL DRILLERS LOG

CODED

SUNFLOWER
H-161
8-2-80

8/2 1980 DYER WELL + IRR SUNFLOWER
 date well completed firm name county well located

LANDOWNER:
JOHN S. PARKER
SUNFLOWER, MISS
 (mailing address)

description of formations encountered	from	to
CLAY	0	28
FINE SAND	28	40
SAND	40	58
SAND & GRAVEL	58	113

WELL LOCATION:
 sec 33 T 21 S R 3 E
5 miles NE of SUNFLOWER
 (distance) (direction) (nearest town)
2 SE DODDSTOWN

WELL PURPOSE:
 (home, irrigation, municipal, industrial)
irrigation

WELL COMPLETION DATA:

(1) diameter (inches) 16

(2) total depth (feet) 113

(3) static water level (feet) 19 below above top of ground.

(4) casing STEEL, 7.3
 (material) (depth)
16 if telescope see back.
 (size)

(5) screen 40, 7.3
 (length) (depth to top)
16, STEEL
 (size) (material)

(6) pump 60, 3000
 (HP) (yield gpm)
DIESEL
 (type power)

(7) electric log NO
 (yes or no)
 (organization running log)

(8) how well bottom plugged STEEL PLATE

DRILLERS REMARKS:


DEPT. OF NATURAL RESOURCES
 BUREAU OF LAND & WATER RESOURCES

SEP 18 1980

RECEIVED

If well telescopes please sketch and show depths.

GROUND LEVEL

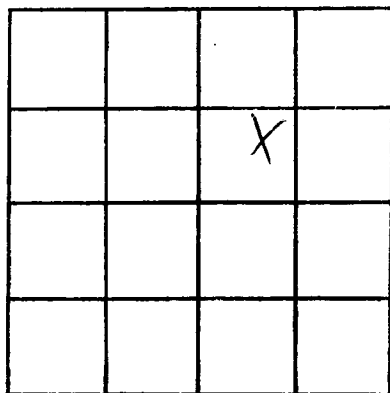

SECTION 33

Please indicate well location X.

ADDITIONAL INFORMATION

If more than one screen,
show locations of each on sketch.