

SUNFLOWER

H 2001

MISSISSIPPI
 BOARD OF WATER COMMISSIONERS
 416 North State Street
 Jackson, Mississippi 39201

WATER WELL DRILLERS LOG
 BUTANE GAS COMPANY

7-21-78 19
 date well completed

OF GREENWOOD

Sunflower
 county well located

LANDOWNER:	description of formations encountered	from	to
H.C. Eastland Doddsville (mailing address)	Clay Sand Sand + Gravel	0 70 90	70 70 100
WELL LOCATION: sec. 32 T. 21 N. R. 3 E S W 1 miles S of Doddsville (distance) (direction) (nearest town)			
WELL PURPOSE: <u>WATER</u> (home, irrigation, municipal, industrial)			
WELL COMPLETION DATA: (1) diameter (inches) <u>4"</u> (2) total depth (feet) <u>100</u> (3) static water level (feet) <u>25</u> below above top of ground. (4) casing <u>PVC</u> <u>90</u> (material) (depth) <u>4"</u> if telescope see back. (size) (5) screen <u>10"</u> <u>90</u> (length) (depth to top) <u>4"</u> <u>PVC</u> (size) (material) (6) pump <u>1/2</u> <u>10</u> (HP) (yield gpm) <u>Elec.</u> (type power) (7) electric log <u>NO</u> (yes or no) (organization running log) (8) how well bottom plugged <u>BACK PRESSURE VALVE</u>			
DRILLERS REMARKS:			


RECEIVED

JUL 27 1978

MISS. BD. OF WATER COMM.

If well telescopes please sketch and show depths.

GROUND LEVEL

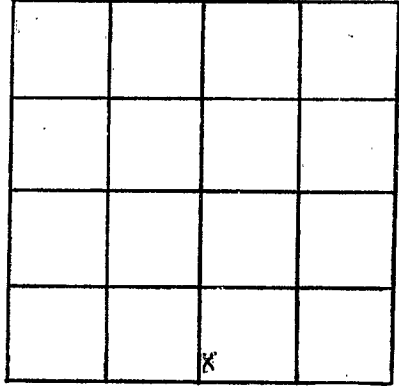

SECTION 32

Please indicate well location X.

ADDITIONAL INFORMATION

A series of horizontal lines for writing additional information.

If more than one screen, show locations of each on sketch.