

Bureau of Land and Water Resources

P. O. Box 10631

Jackson, MS 39289-0631

WATER WELL DRILLERS LOG

COUNTY WELL LOCATED <i>Sunflower</i>		MISSISSIPPI DEPARTMENT OF AGRICULTURE DIVISION OF WATER RESOURCES
WELL NUMBER <i>H</i>	CODED	
DATE WELL COMPLETED <i>2003</i> <i>4-24-91</i>		PERMIT NUMBER
		NAME OF DRILLING FIRM IRRIGATION EQUIPMENT 601/887-2555

INDIANOLA, MS

NAME & MAILING ADDRESS OF LANDOWNER
INDIANOLA, MS

PECAN FARMS

514 ARNOLD AVE.

Greenville, MS 38701

WELL LOCATION: SEC. 24 TOWNSHIP 21 RANGE 3

DISTANCE 4 MILES DIRECTION EAST NEAREST TOWN Docksville

OTHER LANDMARK

WELL PURPOSE: Home, Irrigation, Municipal, Industrial, Fish Pond, etc.

Irrigation

PUMP DATA

PUMP DATA		
PUMP TYPE (Circle One):		
Submersible, <u>Turbine</u>	Jet	Flowing Well,
Other (Describe) _____		
POWER TYPE (Circle One):		
Electric, Tractor, <u>Diesel</u>	Gasoline,	Butane,
Other (Describe) _____		H/P <u>60</u>
Pump Capacity (GPM)	No. of Stages	Setting Depth
<u>3000</u>	<u>1</u>	<u>60</u> FT.
PUMP TEST		
Well yielded _____ GPM with		
a drawdown of _____ ft.		
after _____ hours of pumping		

WELL DATA

Well Depth <i>115</i>	Casing Diameter (In.) <i>16</i>	Casing Length (Ft.) <i>75</i>
Type of Casing <i>PVC</i>	Hole Depth <i>115</i>	Depth to Static Water Level <i>30'</i>
TYPE OF COMPLETION: (Circle One or More): <input checked="" type="checkbox"/> Gravel Packed, <input type="checkbox"/> Underreamed, <input type="checkbox"/> Telescoped, <input type="checkbox"/> Natural Development, <input type="checkbox"/> Open Hole, <input type="checkbox"/> Other (Describe) _____		
Top of Lap Pipe or Reduction in Casing		
FEET		IF TELESCOPED OR MORE THAN ONE SCREEN: USE BACK PAGE

LOG DATA

TYPE OF LOG RUN (Circle One): _____ No Log Run, Electric, Gamma Ray, Density, Sonic, Neutron, Other (Describe) _____
Name of Organization Running Log _____

GEOLOGIC DATA (Office Use Only)

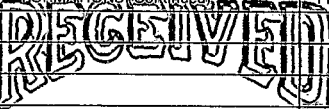
Surface Elev.	Geologic Unit	Unit Thickness	Depth to Top
Subs. SWL	Date	Analysis	Aquifer Test

SCREEN DATA

Diameter - Inches 16	Length - Feet 40	Slot Size - Inches .050
Screen Type PVC		Depth to Bottom - Feet 115

Driller's Remarks

Huber Farm Services

DESCRIPTION OF FORMATIONS ENCOUNTERED	FROM	TO	FORMATIONS (Continued)	FROM	TO
clay	0	25	 APR 30 1991		
Fine SAND	25	35			
medium SAND	35	65			
Coarse SAND	65	85			
Coarse SAND + GRAVEL	85	95			
Coarse SAND	95	105	Dept. of Environmental Quality Bureau of Land & Water Resources		
Coarse SAND + GRAVEL	105	115			
			IF MORE SPACE IS NEEDED, USE BACK		

IF MORE SPACE IS NEEDED, USE BACK

If well telescopes please
sketch and show depths.

GROUND LEVEL

X			

SECTION

24

Please indicate well location X.

ADDITIONAL INFORMATION

If more than one screen,
show location of each on sketch.