

DEQ

MISSISSIPPI DEPARTMENT OF ENVIRONMENTAL QUALITY
Office of Land and Water Resources
P. O. Box 2309
Jackson, MS 39225
Water Well Plugging/Decommissioning Form
OLWR-DF-1 (04/08)


no drill log


COUNTY WELL LOCATED: Sunflower		WELL NUMBER: J
PERMIT NUMBER: GW-36628	DATE WELL PLUGGED: 9-24-2019	
NAME OF FIRM PLUGGING WELL: Irrigation Equipment Inc.	TELEPHONE NUMBER: 662-887-2555	
NAME AND ADDRESS OF CURRENT LANDOWNER: IAI USA Fund c/o Westchester Group 2004 Fox Drive, Suite L	Champaign IL 61820	
WELL LOCATION: SECTION: 20	TOWNSHIP: 20N	RANGE: 5W
WELL LOCATION: LATITUDE: 33 34 14.5	LONGITUDE: 90 44 16.2	METHOD (CIRCLE ONE): (1) USGS QUAD (2) CONVENTIONAL SURVEY (3) GPS - HAND HELD OR SURVEY GRADE
DISTANCE:	DIRECTION:	NEAREST TOWN: Shaw OTHER LANDMARK:
WELL PURPOSE (HOME, IRRIGATION, MUNICIPAL, ETC.):	Irrigation	
NAME OF WELL CONTRACTOR WHO DRILLED THE WELL:		
NAME OF LANDOWNER WHEN WELL WAS DRILLED:		

WELL DATA		
WELL DEPTH: 126Ft.	HOLE DEPTH:	
CASING DIAMETER (IN.): 10	CASING LENGTH (FT.):	TYPE OF CASING: PVC
DEPTH TO STATIC WATER LEVEL: 42Ft.	DATE WELL COMPLETED:	
WHY IS THE WELL BEING ABANDONED? Pumped Sand-Replaced		

DESCRIBE HOW THE WELL OR HOLE WAS PLUGGED (AMOUNT OF CASING AND/OR SCREEN THAT WAS REMOVED OR LEFT IN HOLE, MATERIAL AND AMOUNT USED IN PLUGGING, METHOD OF PLACING MATERIAL, ETC.) Removed casing below ground level. Installed 5% chlorine bleach. Installed sand and gravel. Installed 800 pounds of bentonite hole plug.
New Well: GW-50979

RECEIVED
OCT 14 2019
BY OLWR

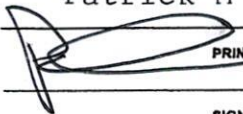I CERTIFY THAT THE WELL WAS PLUGGED OR ABANDONED IN ACCORDANCE WITH THE STATE OF MISSISSIPPI REGULATIONS.	
Patrick M Chism	0695
	MS LICENSE NUMBER
PRINT NAME	10-10-2019
SIGNATURE	DATE

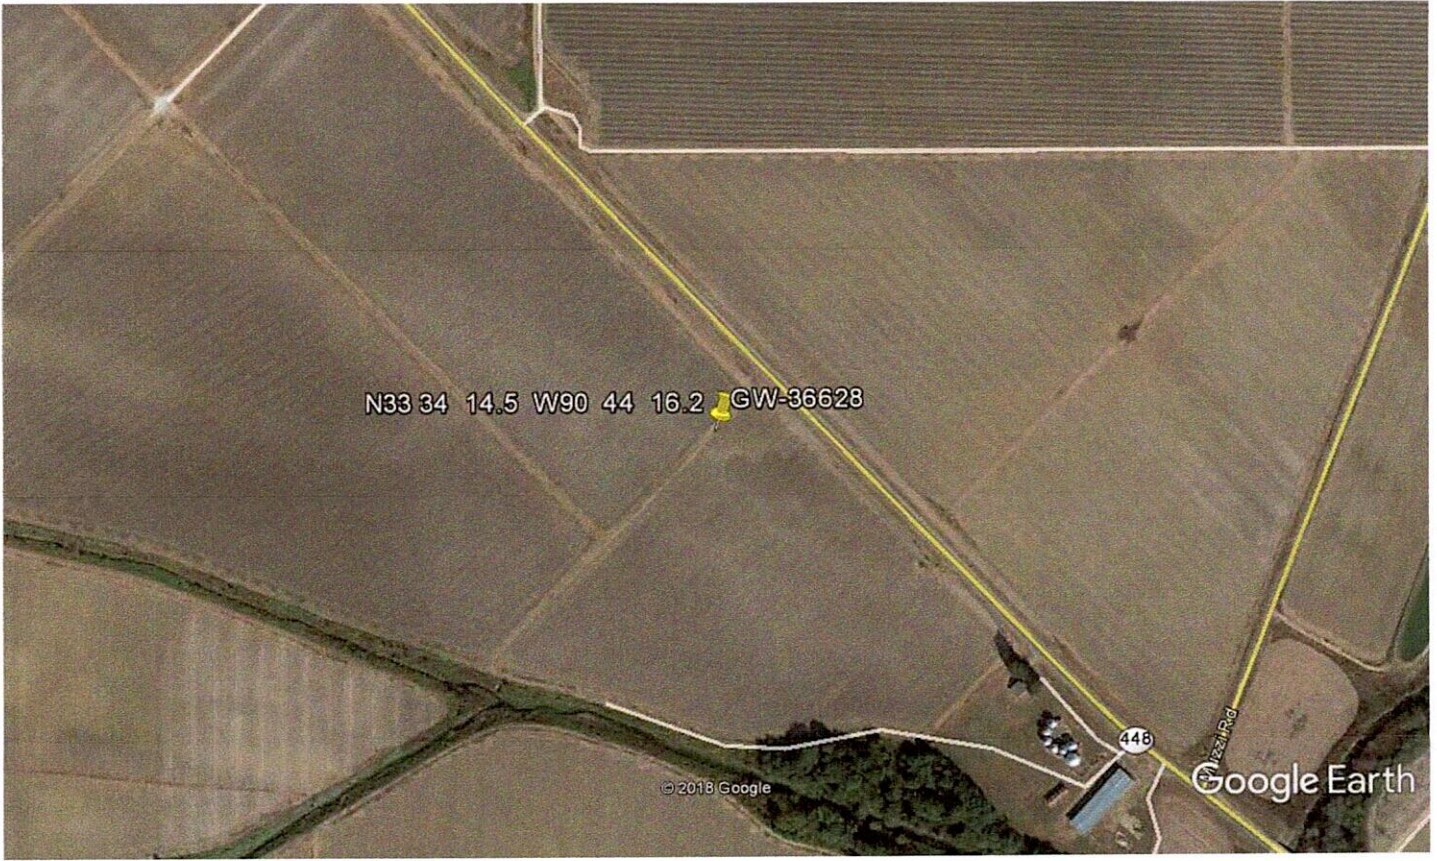

N33 34 14.5 W90 44 16.2 GW-36628

© 2018 Google

448

Google Earth

Google Earth



RECEIVED
OCT 14 2019
BY OLWR