

Sumflow
513
10-14-68

MISSISSIPPI
 BOARD OF WATER COMMISSIONERS
 416 North State Street
 Jackson, Mississippi 39201

CODED

WATER WELL DRILLERS LOG

10/14/68 19 Delta Well Supplies Sumflow
 date well completed firm name county well located

LANDOWNER:

Jimmie Simpson
Shaw, Miss
 (mailing address)

description of formations encountered

from to

<u>Top soil</u>	<u>0</u>	<u>4</u>
<u>Cl. Clay</u>	<u>4</u>	<u>35</u>
<u>Fine Sand</u>	<u>55</u>	<u>67</u>
<u>Clay blue</u>	<u>67</u>	<u>86</u>
<u>Fine sand</u>	<u>81</u>	<u>92</u>
<u>Clay blue</u>	<u>92</u>	<u>95</u>
<u>Sand Med.</u>	<u>95</u>	<u>130</u>

WELL LOCATION:


sec. 20 T 20 N R. 5 E W
3 miles SE of Shaw
 (distance) (direction) (nearest town)

WELL PURPOSE: Irrigation
 (home, irrigation, municipal, industrial)

WELL COMPLETION DATA:

- (1) diameter (inches) 12
- (2) total depth (feet) 129
- (3) static water level (feet) 21 below above top of ground.
- (4) casing steel (material) (depth)
- (size) if telescope see back.
- (5) screen 36 , 93 (length) (depth to top)
- 12 , steel (size) (material)
- (6) pump 30 (HP) 1150 (yield gpm)
- LP gas (type power)
- (7) electric log (yes or no)
- (organization running log)
- (8) how well bottom plugged Correct

CODED

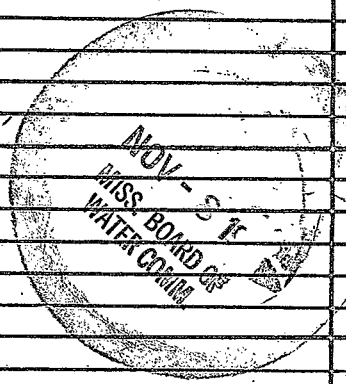

DRILLERS REMARKS:

If well telescopes please sketch and show depths.

GROUND LEVEL



SECTION 20

Please indicate well location X.

ADDITIONAL INFORMATION

If more than one screen, show locations of each on sketch.