

m

CODED

11/29/69  
Jr

SUNFLOWER  
J 14  
8-6-69

MISSISSIPPI  
BOARD OF WATER COMMISSIONERS  
416 North State Street  
Jackson, Mississippi 39201

WATER WELL DRILLERS LOG

C2989

August 6, 1969 Layne-Central Company Sunflower  
date well completed firm name county well located

LANDOWNER: C. T. Ellis  
Route 2  
Indianola, Mississippi  
(mailing address)

description of formations encountered	from	to
Hard clay	0	36
Clay balls	36	48
Coarse sand and pea gravel	48	92

WELL LOCATION:  
sec. 13 T 20 N R. 5 E W  
6 miles east of Shaw  
(distance) (direction) (nearest town)

WELL PURPOSE: irrigation  
(home, irrigation, municipal, industrial)

WELL COMPLETION DATA:

- (1) diameter (inches) 10
- (2) total depth (feet) 92
- (3) static water level (feet) 11' 6" <sup>below</sup> ~~above~~ top of ground.
- (4) casing steel, 62' (material), (depth)  
10" (size) if telescope see back.
- (5) screen 30' (length), 92' (depth to top)  
10" (size), Armco (material)
- (6) pump 30 (HP), 800 (yield gpm)  
engine (type power)
- (7) electric log no (yes or no)  
(organization running log)
- (8) how well bottom plugged plate


NOV 26 1969

MISS. BD. OF  
WATER COMM.

DRILLERS REMARKS:

If well telescopes please  
sketch and show depths.

GROUND LEVEL

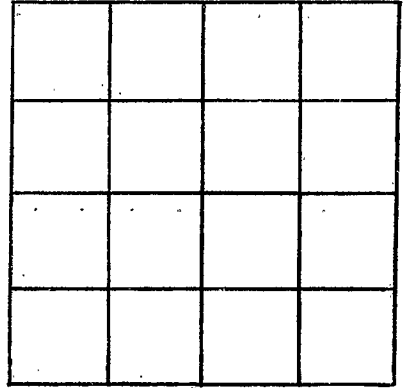

SECTION \_\_\_\_\_

Please indicate well location X.

ADDITIONAL INFORMATION

If more than one screen,  
show locations of each on sketch.