

SUNF.
J17
6-15-63

WATER WELL DRILLERS LOG

CODED

Date: 6/15, 1963, Driller: Delta Well Drilling Co. Gulfport, Miss.
(Name)

(1) Owner of Land Shaw Pleasant
(Name)
Shaw Miss.
(Address)

(2) Location: 1/4, 1/4, Sec. 7 T20R5
1 miles So. East of Shaw
(distance) (direction) (Nearest Town)

(3) Topography: (Level)
(Hilly) (Flat)

(4) Purpose of Well: _____
(Domestic Irrigation, Municipal, Industrial, Other)

Description & Color of Materials Sand, Clay, Red Clay, Shell, etc.	Thick- ness Feet	Depth Feet
<u>sand clay</u>		<u>16</u>
<u>fine sand</u>	<u>34</u>	<u>40</u>
<u>Med "</u>	<u>12</u>	<u>52</u>
<u>Coarse "</u>	<u>30</u>	<u>82</u>
<u>Grave Course Sand</u>	<u>20</u>	<u>102</u>
<u>Medium "</u>	<u>9</u>	<u>111</u>

Information upon completion of well:

(1) Diameter 12 inches.

(2) Total Depth 111 feet.

(3) Water Level 17 feet below top of ground.

(4) Cased to _____, Size _____


(5) Screen: Size 12", Length 40 ft.

(6) Were any formations sealed against pollution?
_____ yes, _____ no.

If YES, depth of formation _____

Why _____

Drillers Remarks: _____

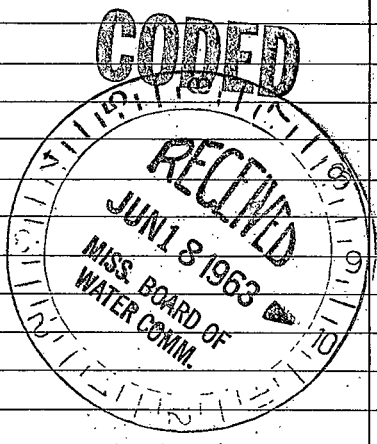

(Use Back Side)

Well No.

100