

Sun Flower

Bolivar

J20

8-19-74

MISSISSIPPI BOARD OF WATER COMMISSIONERS
416 North State Street
Jackson, Mississippi 39201

CODED

WATER WELL DRILLERS LOG

Sun Flower

8/19

date well completed

1974 Delta Well Supply Co

firm name

Bolivar

county well located

LANDOWNER:

Jimmie B. Maxwell, Jr.
P.O. Box 47A, Shaw - Miss.
(mailing address)

description of formations encountered

from to

Topsoil	0	15
Clay	15	40
Sanded Sand	40	65
Sandstone - P. Permian	65	117

WELL LOCATION:

sec 17 T 20 N R 5 E
2 miles S of Shaw
(distance) (direction) (nearest town)

WELL PURPOSE: Domestic
(home, irrigation, municipal, industrial)


WELL COMPLETION DATA:

- (1) diameter (inches) 12
- (2) total depth (feet) 117
- (3) static water level (feet) 20 below top of ground.
- (4) casing steel (material) (depth)
- (5) screen 26 ft (length); (depth to top)
- (6) pump 40 (HP); 2000 (yield gpm)
- (7) electric log 210 (yes or no)
- (8) how well bottom plugged steel plate

DRILLERS REMARKS:

If well telescopes please sketch and show depths.

GROUND LEVEL

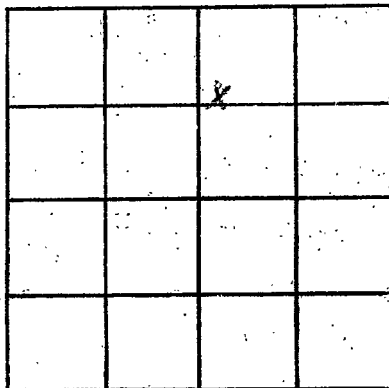

SECTION 17

Please indicate well location X.

ADDITIONAL INFORMATION

Lined area for additional information.

If more than one screen, show locations of each on sketch.