

SUNFLOWER
J21
12-12-74

MISSISSIPPI
BOARD OF WATER COMMISSIONERS
416 North State Street
Jackson, Mississippi 39201

WATER WELL DRILLERS LOG

12/12/74 date well completed BUTANE GAS CO. OF GREENWOOD firm name Sunflower county well located

LANDOWNER:
Jimmie Simpson
SHAW
(mailing address)

WELL LOCATION:
sec. 18 T 20 N R 5 E
6 S W
4 miles SE of SHAW
(distance) (direction) (nearest town)

WELL PURPOSE:
(home, irrigation, municipal, industrial)


- WELL COMPLETION DATA:
- (1) diameter (inches) 16"
 - (2) total depth (feet) 110
 - (3) static water level (feet) 18' below top of ground.
 - (4) casing Steel 70' (material) (depth)
16" (size) if telescope see back.
 - (5) screen 40' 70' (length) (depth to top)
16" Steel (size) (material)
 - (6) pump (HP) (yield gpm)
(type power)
 - (7) electric log (yes or no)
(organization running log)
 - (8) how well bottom plugged
Steel plate

description of formations encountered	from	to
CLAY	0	10
Blue Clay	10	30
Fine Sand	30	50
COARSE SAND-Gravel	50	70
Gravel	70	110
CODED		
RECEIVED DEC 18 1974 MISS. Bd. OF WATER		

DRILLERS REMARKS:

If well telescopes please
sketch and show depths.

GROUND LEVEL

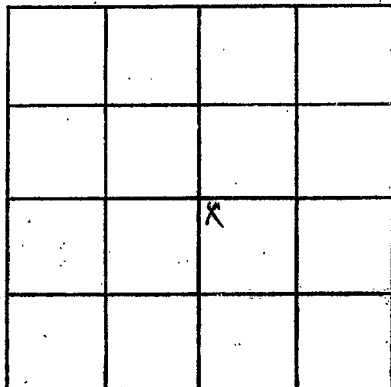

SECTION 18

Please indicate well location X.

ADDITIONAL INFORMATION

If more than one screen,
show locations of each on sketch.