

SUNFLOWER
J22
12-6-74

MISSISSIPPI
BOARD OF WATER COMMISSIONERS
416 North State Street
Jackson, Mississippi 39201 **CODED**

WATER WELL DRILLERS LOG

ENTANE GAS CO. OF GREENWOOD *Sunflower*

12-6-74 19
date well completed


firm name

county well located

LANDOWNER:	description of formations encountered	from	to
<i>Vince Muzzi</i> <i>Shaw, Miss.</i> (mailing address)			
WELL LOCATION: sec. <u>17</u> T. <u>20</u> N R. <u>5</u> E S W <u>5</u> miles <u>SE</u> of <u>SHAW</u> (distance) (direction) (nearest town)			
WELL PURPOSE: <u>IRR.</u> (home, irrigation, municipal, industrial)			
WELL COMPLETION DATA: (1) diameter (inches) <u>16"</u> (2) total depth (feet) <u>110</u> (3) static water level (feet) <u>18</u> below top of ground. (4) casing <u>Steel</u> , <u>70</u> , (material) (depth) <u>16"</u> If telescope see back. (size) (5) screen <u>40'</u> , <u>70</u> (length) (depth to top) <u>16"</u> , <u>Steel</u> (size) (material) (6) pump <u>50</u> , <u>2500</u> (HP) (yield gpm) <u>Diesel</u> (type power) (7) electric log <u>No</u> (yes or no) (organization running log) (8) how well bottom plugged <u>Steel Plate</u>			
DRILLERS REMARKS:	CODED RECORDED DEC 19 1974 MISS. DEPT. OF WATER		

If well telescopes please sketch and show depths.

GROUND LEVEL

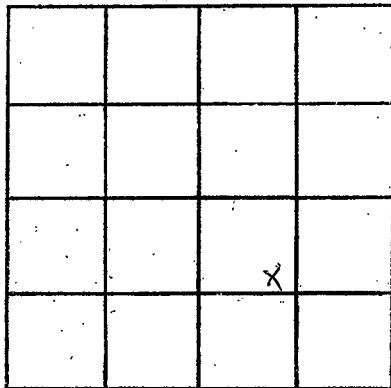

SECTION 17

Please indicate well location X.

ADDITIONAL INFORMATION

If more than one screen, show locations of each on sketch.