

Sunflower  
J 25  
6-67

MISSISSIPPI  
BOARD OF WATER COMMISSIONERS  
416 North State Street  
Jackson, Mississippi 39201

WATER WELL DRILLERS LOG

June 1967 BOTAQUE GAS CO Sunflower  
date well completed firm name GREENWOOD county well located

LANDOWNER:  
J. V. Fox  
Route 1 - SHAW, MISS.  
(mailing address)  
WELL LOCATION:  
sec 1 T 20 N R 5 E  
S E  
8 miles SW of Dicksboro  
(distance) (direction) (nearest town)


WELL PURPOSE: Home  
(home, irrigation, municipal, industrial)

WELL COMPLETION DATA:  
(1) diameter (inches) 4" x 2"  
(2) total depth (feet) 1259'  
(3) static water level (feet) 2' <sup>below</sup> 4' <sup>above</sup>  
top of ground. - 105'  
(4) casing 32" - 1134'  
(material) (depth)  
4" x 2" If telescope see back.  
(size)  
(5) screen 20' 1239'  
(length) (depth to top)  
2" STAINLESS STEEL  
(size) (material)  
(6) pump 1 1/2 20  
(HP) (yield gpm)  
Electric  
(type power)  
(7) electric log No  
(yes or no)


(organization running log)  
(8) how well bottom plugged  
Back Pressure Valve 2

DRILLERS REMARKS: Lead Plug

description of formations encountered	from	to
<u>FINE H.P. SAND.</u>	<u>1224</u>	<u>1260</u>
<u>FDW Sub. Pump</u>		
<u>1 1/2 HP</u>		
<u>Set on 2" Galv. Pipe</u>		
<u>22' Galv. Pipe</u>		

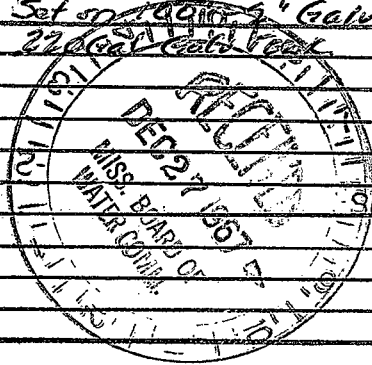

If well telescopes please sketch and show depths.

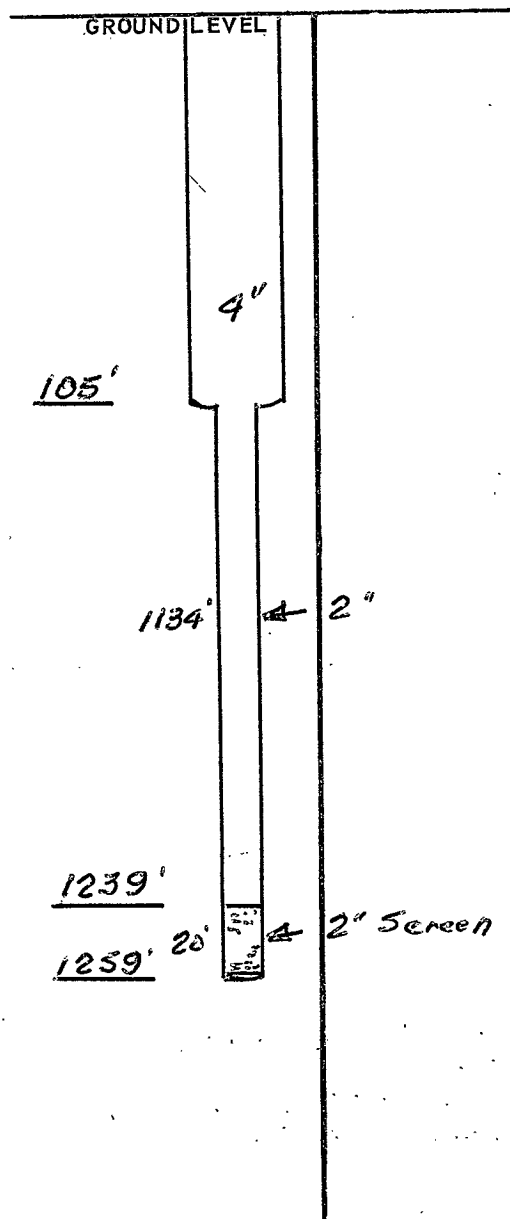

			X

SECTION   1  

Please indicate well location X.

ADDITIONAL INFORMATION


If more than one screen, show locations of each on sketch.