

Sunflower
 T 26
 5-66

MISSISSIPPI BOARD OF WATER COMMISSIONERS

WATER WELL DRILLERS LOG

Sunflower

Date: May 16, 1966, Driller: Butane Gas Co. County: Jefferson
 (Name)

(1) Owner of Land: Vincent Mutzi
 (Name)
Shaw, Miss.
 (Address)

(2) Location: SE 1/4, NE 1/4, Sec. 25 TN R 4W
20 S
6 miles East of Shaw
 (distance) (direction) (Nearest Town)

(3) Topography: Flat
 (Hilly) (Flat) (Level)

(4) Purpose of Well: Irrigation
 (Domestic Irrigation
 Municipal, Industrial, Other)

Description & Color of Materials Sand, Clay, Red Clay, Shell, etc.	Thick- ness Feet	Depth Feet
Top soil	13	13
Fine Sand	10	23
" "	10	33
Coarse Sand	10	43
Fine sand	10	53
Sand & gravel	10	63
Medium sand	10	73
" "	10	83
Coarse sand & gravel	10	93
" " "	10	103

Information upon completion of well:

(1) Diameter 16 inches.

(2) Total Depth 103 feet.

(3) Water Level 15 feet below top of ground.

(4) Cased to 73, Size 16


(5) Screen: Size 16, Length 40

(6) Were any formations sealed against pollution?
X yes, no.

If YES depth of formation _____

Why _____

Drillers Remarks: _____

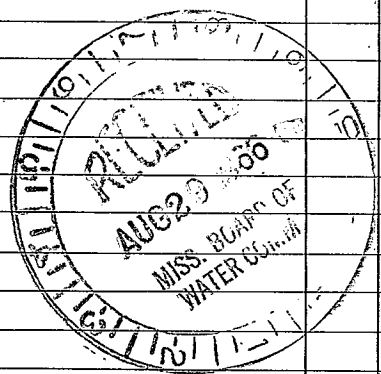

(Use Back Side)

Well No.

Retain this copy for your office files.

