

J 27

5-66

WATER WELL DRILLERS LOG

Sunflower

Date: May 21, 1966, Driller: Butane Gas Co. County: Jeffere

(Name)

(1) Owner of Land: Lee Quicci
(Name)
Shaw, Miss.
(Address)

(2) Location: NW 1/4, SE 1/4, Sec. 7 T²⁰ N⁵ R²⁰ W
1 1/2 miles East of Shaw
(distance) (direction) (Nearest Town)
Flat
(Hilly) (Flat) (Level)

(3) Topography: Flat
(Hilly) (Flat) (Level)

(4) Purpose of Well: Irrigation
(Domestic Irrigation
 Municipal, Industrial, Other)

Description & Color of Materials Sand, Clay, Red Clay, Shell, etc.	Thick- ness Feet	Depth Feet
Clay	13	13
"	10	23
Coarse sand & small gravel	10	33
" " " "	10	43
Fine sand & gravel	10	53
" " "	10	63
" " "	10	73
Sand & gravel	10	83
" "	10	93
" "	10	103

Information upon completion of well:

(1) Diameter 16 inches.

(2) Total Depth 105 feet.

(3) Water Level 15 feet below top of ground.

(4) Cased to 66, Size 16


(5) Screen: Size 16, Length 40

(6) Were any formations sealed against pollution?
no yes, no.

If YES depth of formation _____

Why _____

Drillers Remarks: _____

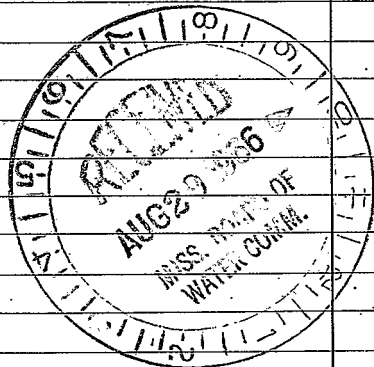

(Use Back Side)

Well No.

