

Sunflower  
 J 28  
 6-23-66

MISSISSIPPI BOARD OF WATER COMMISSIONERS

WATER WELL DRILLERS LOG

Date: 6/23, 1966, Driller: Delta Well Supply Co. County: Sunflower  
 (Name)

(1) Owner of Land: Morris Whitzic  
 (Name)  
Shaw, Miss.  
 (Address)  
 (2) Location: 5<sup>20</sup>/<sub>4</sub>, 1/4, Sec. 7 T20 N 8 R17 W  
1/4 miles to east of Shaw  
 (distance) (direction) (Nearest Town)  
 (3) Topography: Flat  
 (Hilly) (Flat) (Level)  
 (4) Purpose of Well: Irrigation  
 (Domestic, Irrigation, Municipal, Industrial, Other)


Description & Color of Materials Sand, Clay, Red Clay, Shell, etc.	Thick-ness Feet	Depth Feet
<u>Topsoil and clay</u>	<u>26</u>	
<u>Sandstone</u>	<u>22</u>	<u>48</u>
<u>Sand</u>	<u>12</u>	<u>60</u>
<u>Coarse sandstone</u>	<u>157</u>	<u>117</u>

Information upon completion of well:

(1) Diameter 10 inches.  
 (2) Total Depth 117 feet.  
 (3) Water Level 20 feet below top of ground.  
 (4) Cased to 87, Size 10  
 (5) Screen: Size 10", Length 30ft.  
 (6) Were any formations sealed against pollution?  
 \_\_\_\_\_ yes,  no.

If YES depth of formation \_\_\_\_\_  
 Why \_\_\_\_\_

Drillers Remarks: \_\_\_\_\_

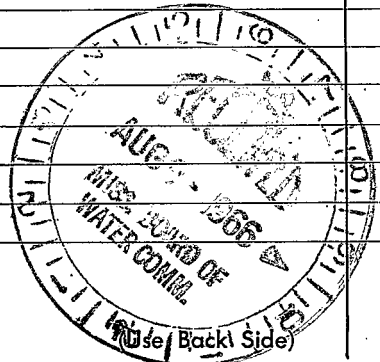

Well No.

