

SUNFLOWER
J 30
6.27-77

MISSISSIPPI
BOARD OF WATER COMMISSIONERS
416 North State Street
15H Jackson, Mississippi 39201

CODED

WATER WELL DRILLERS LOG

Sunflower
Bolivar

6-27 1977 Layne Central Co. date well completed firm name county well located

LANDOWNER: Lyons Bros. Farm
Shaw, MS

(mailing address)

WELL LOCATION:

sec. 29 T. 20 N R. 5 W
4 miles E of Shaw
(distance) (direction) (nearest town)

WELL PURPOSE: Irrigation
(home, irrigation, municipal, industrial)

WELL COMPLETION DATA:

- (1) diameter (inches) 12'
- (2) total depth (feet) 110'
- (3) static water level (feet) 28' below top of ground.
- (4) casing Steel 80'
(material) (depth)
12" If telescope see back.
(size)
- (5) screen 30' 80'
(length) (depth to top)
12" St. Steel
(size) (material)
- (6) pump 40 1200
(HP) (yield gpm)
diesel
(type power)
- (7) electric log No
(yes or no)

(organization running log)

(8) how well bottom plugged St. Plate

DRILLERS REMARKS:

description of formations encountered	from	to
Clay	0	12
Sandy	12	16
Blue Clay	16	56
Coarse Sand - Gravel & Clay Balls	56	70
Coarse Sand	70	80
Coarse Sand - Pea Gravel & Gravel	80	110
Med. Sand to Fine Sand	110	122


CODED

RECEIVED
SEP 18 1977

MISS. BD. OF WATER COMMISSIONERS

If well telescopes please sketch and show depths.

GROUND LEVEL

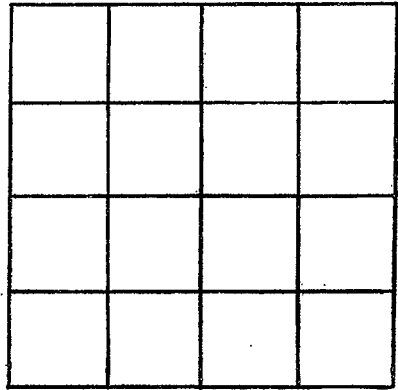

SECTION _____

Please indicate well location X.

ADDITIONAL INFORMATION

If more than one screen, show locations of each on sketch.