

SUNFLOWER
J31
2/6/78

MISSISSIPPI
BOARD OF WATER COMMISSIONERS
416 North State Street
Jackson, Mississippi 39201

CODED

WATER WELL DRILLERS LOG

February 6, 1978 Dyer Well & Irrigation Sunflower
date well completed firm name county well located

LANDOWNER: Vince Muzzi
R.R.
Shaw, Miss.
(mailing address)

WELL LOCATION:
sec. 10 T. 20 N. R. 5 E
4 miles East of Shaw
(distance) (direction) (nearest town)

description of formations encountered	from	to
Clay	0	13
Clay	13	23
Clay	23	33
FINE SAND CODED	33	43
FINE SAND	43	53
FINE SAND + GRAVEL	53	63
SAND + GRAVEL	63	73
SAND + GRAVEL	73	83
SAND + GRAVEL	83	93
SAND + GRAVEL	93	103
SAND + GRAVEL	103	113
Bottom	113	

WELL PURPOSE: Irrigation
(home, irrigation, municipal, industrial)

- WELL COMPLETION DATA:
- (1) diameter (inches) 16"
 - (2) total depth (feet) 113'
 - (3) static water level (feet) 18' below top of ground.
 - (4) casing Steel, 73' (material) (depth)
16" If telescope see back. (size)
 - (5) screen 40', 73' (length) (depth to top)
16", Steel (size) (material)
 - (6) pump 60, 2,000 (HP) (yield gpm)
DIESEL (type power)
 - (7) electric log No (yes or no)
(organization running log)
 - (8) how well bottom plugged Plate

Miss. Board of Water Comm.


FEB 6 1979

RECEIVED

DRILLERS REMARKS:

If well telescopes please sketch and show depths.

GROUND LEVEL

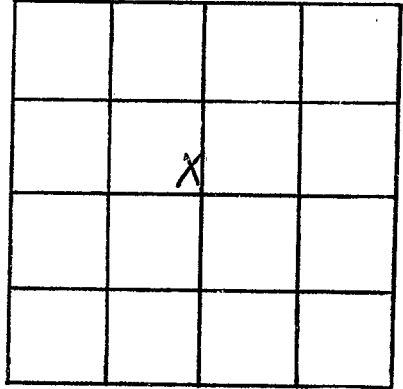

SECTION 10

Please indicate well location X.

ADDITIONAL INFORMATION

Lined area for additional information.

If more than one screen, show locations of each on sketch.

DRILL