

SUNFLOWER

J 32

2/5/78


MISSISSIPPI BOARD OF WATER COMMISSIONERS
416 North State Street
Jackson, Mississippi 39201

CODED

WATER WELL DRILLERS LOG

February 5, 1978 Dyer Well + Irrigation Sunflower
date well completed firm name county well located

LANDOWNER: <u>Jimmy Simpson</u>	description of formations encountered	from	to
<u>Shaw, Miss.</u> (mailing address)	Clay	0	13
WELL LOCATION:	Clay	13	23
sec. <u>17</u> T. <u>20N</u> R. <u>5E</u> S <u>3</u> miles <u>EAST</u> of <u>SAAW</u> (distance) (direction) (nearest town)	Clay CODED	23	33
WELL PURPOSE: <u>Irrigation</u> (home, irrigation, municipal, industrial)	FINE SAND	33	43
WELL COMPLETION DATA:	FINE SAND	43	53
(1) diameter (inches) <u>16"</u>	FINE SAND + GRAVEL (SF)	53	63
(2) total depth (feet) <u>113'</u>	SAND + GRAVEL	63	73
(3) static water level (feet) <u>18'</u> below top of ground.	SAND + GRAVEL	73	83
(4) casing <u>Steel</u> <u>73'</u> (material) (depth)	SAND + GRAVEL	83	93
<u>16"</u> if telescope see back. (size)	SAND + GRAVEL	93	103
(5) screen <u>40'</u> <u>73'</u> (length) (depth to top)	SAND + GRAVEL	103	113
<u>16"</u> <u>Steel</u> (size) (material)			
(6) pump <u>600</u> <u>2,000</u> (HP) (yield gpm)			
<u>Diesel</u> (type power)			
(7) electric log <u>No</u> (yes or no)			
(organization running log)			
(8) how well bottom plugged <u>Plugs</u>			
DRILLERS REMARKS:			

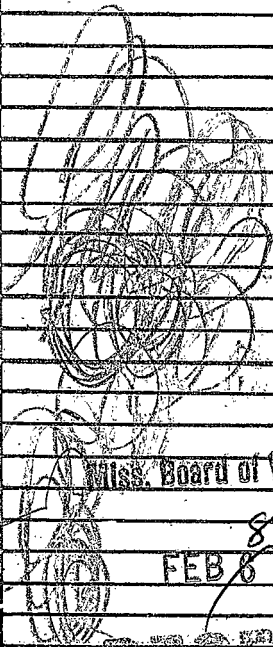

Miss. Board of Water Comm.

FEB 6 1979

RECEIVED

