

SUNFLOWER
J 35
1/15/79

MISSISSIPPI
BOARD OF WATER COMMISSIONERS
416 North State Street
Jackson, Mississippi 39201

CODED

WATER WELL DRILLERS LOG

Jan. 15, 1979 Dyer Well + Irrigation Sunflower
date well completed firm name county well located

LANDOWNER: Jimmy Muzzi	description of formations encountered	from	to
Shaw, Miss. (mailing address)	Clay + Brown SAND	0	16
WELL LOCATION: sec. 28 T. 20N R. 5E S W	FINE SAND + GRAVEL	16	33
4 miles SW of Shaw (distance) (direction) (nearest town)	SAND	33	58
WELL PURPOSE: Irrigation (home, irrigation, municipal, industrial)	SAND + GRAVEL	58	113
WELL COMPLETION DATA:	Bottom 113' CODED		
(1) diameter (inches) 16"			
(2) total depth (feet) 113'			
(3) static water level (feet) 18' below top of ground.			
(4) casing STEEL, 73' (material) (depth)			
16" if telescope see back. (size)			
(5) screen 40', 73' (length) (depth to top)			
16" STEEL (size) (material)			
(6) pump 60 2000 (HP) (yield gpm)			
DIESEL (type power)			
(7) electric log No (yes or no)			
(organization running log)			
(8) how well bottom plugged Plate			
DRILLERS REMARKS:			


Miss. Board of Water Comm.

MAR 14 1979

RECEIVED

If well telescopes please sketch and show depths.

GROUND LEVEL

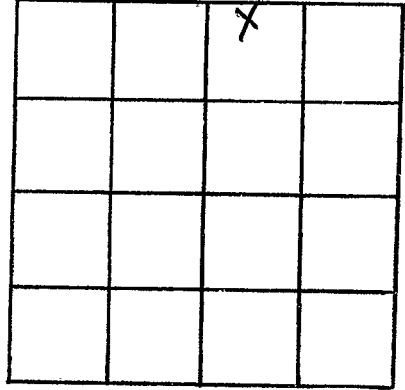

SECTION 28

Please indicate well location X.

ADDITIONAL INFORMATION

If more than one screen,
show locations of each on sketch.