

SUNFLOWER
J36
1/20/79

MISSISSIPPI
BOARD OF WATER COMMISSIONERS
416 North State Street
Jackson, Mississippi 39201

CODED

WATER WELL DRILLERS LOG

JANUARY 20, 1979 Dyer Well + Irrigation Sunflower
date well completed firm name county well located

LANDOWNER: <u>Jim + Vince Muzzi</u>	description of formations encountered	from	to
<u>Shaw, Miss</u> (mailing address)	<u>Clay</u>	<u>0</u>	<u>23</u>
WELL LOCATION: sec. <u>8</u> T <u>20</u> (N) R. <u>5</u> (E) <u>3</u> miles <u>W</u> of <u>SHAW</u> (distance) (direction) (nearest town)	<u>Fine SAND</u>	<u>23</u>	<u>48</u>
WELL PURPOSE: <u>Irrigation</u> (home, irrigation, municipal, industrial)	<u>SAND</u>	<u>48</u>	<u>85</u>
WELL COMPLETION DATA: (1) diameter (inches) <u>16"</u>	<u>SAND + GRAVEL</u>	<u>85</u>	<u>103</u>
(2) total depth (feet) <u>113'</u>	<u>SAND</u>	<u>103</u>	<u>113</u>
(3) static water level (feet) <u>17'</u> below top of ground.	<u>Bottom 113 / CODED</u>		
(4) casing <u>STEEL</u> , <u>73'</u> (material) (depth)			
<u>16"</u> if telescope see back. (size)			
(5) screen <u>40'</u> , <u>73'</u> (length) (depth to top)			
<u>16"</u> , <u>STEEL</u> (size) (material)			
(6) pump <u>60</u> <u>3,000</u> (HP) (yield gpm)			
<u>Diesel</u> (type power)			
(7) electric log <u>No</u> (yes or no)			
(8) how well bottom plugged <u>Plate</u> (organization running log)			
DRILLERS REMARKS:			


Miss. Board of Water Comm.

MAR 14 1979

RECEIVED

If well telescopes please sketch and show depths.

GROUND LEVEL

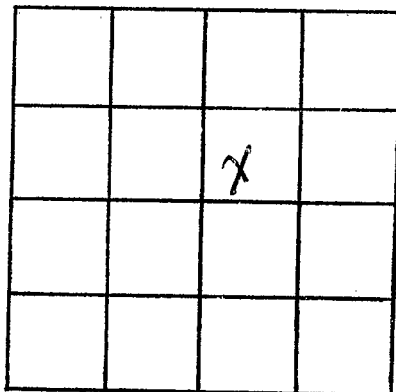

SECTION 8

Please indicate well location X.

ADDITIONAL INFORMATION

If more than one screen,
show locations of each on sketch.