

Sunflower
J37
6-20-80

MISSISSIPPI
 BOARD OF WATER COMMISSIONERS
 416 North State Street
 Jackson, Mississippi 39201

CODED
Sunflower

WATER WELL DRILLERS LOG

6/20 19 *80* *Dyer* *Bellevue*
 date well completed firm name county well located

LANDOWNER:
JIM MUZZI
SHAW, MS
 (mailing address)

description of formations encountered	from	to
Clay @ - 28'	0	28
FINE SANDS	28	38
SAND	38	45
SAND & GRAVEL	45	93

WELL LOCATION:
 sec. 32 T. 20 N. R. 5 E.
6 miles SE of Shaw
 (distance) (direction) (nearest town)

WELL PURPOSE:
 (home, irrigation, municipal, industrial)

WELL COMPLETION DATA:

(1) diameter (inches) 12"

(2) total depth (feet) 93'

(3) static water level (feet) 22' below top of ground.

(4) casing steel 93'
 (material) (depth)
12" if telescope see back.
 (size)

(5) screen 40' 53'
 (length) (depth to top)
12" steel
 (size) (material)


(6) pump 40 2000
 (HP) (yield gpm)
diesel
 (type power)

(7) electric log
 (yes or no)

 (organization running log)

(8) how well bottom plugged date


CODED

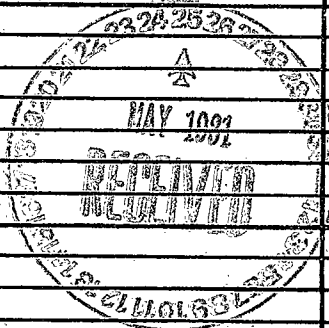

DRILLERS REMARKS:

If well telescopes please sketch and show depths.

GROUND LEVEL

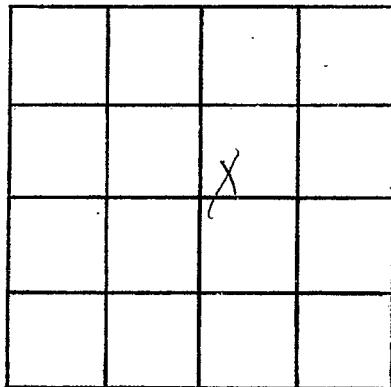

SECTION 32

Please indicate well location X.

ADDITIONAL INFORMATION

If more than one screen, show locations of each on sketch.