

Sunflower  
J39  
2-5-80

MISSISSIPPI  
 BOARD OF WATER COMMISSIONERS  
 416 North State Street  
 Jackson, Mississippi 39201

CODED

WATER WELL DRILLERS LOG

2/5 1980 Dum Sum  
 date well completed firm name county well located

LANDOWNER:  
VIRGIL REDD  
SHAW, MS  
 (mailing address)

description of formations encountered	from	to
<u>clay</u>	<u>0</u>	<u>28</u>
<u>fine sand</u>	<u>28</u>	<u>38</u>
<u>sand</u>	<u>38</u>	<u>45</u>
<u>sand &amp; gravel</u>	<u>45</u>	<u>103</u>

WELL LOCATION:  
 sec. 17 T 20 S R 5 E  
4 miles SE of Shaw  
 (distance) (direction) (nearest town)

WELL PURPOSE:  
 (home, irrigation, municipal, industrial)

CODED

WELL COMPLETION DATA:

(1) diameter (inches) 10"

(2) total depth (feet) 103'

(3) static water level (feet) 22' below top of ground.


(4) casing Steel 103'  
 (material) (depth)  
10" if telescope see back.  
 (size)

(5) screen 48" 63'  
 (length) (depth to top)  
10" Steel  
 (size) (material)

(6) pump 10 1200  
 (HP) (yield gpm)  
electric  
 (type power)

(7) electric log             
 (yes or no)  
            
 (organization running log)


(8) how well bottom plugged plate

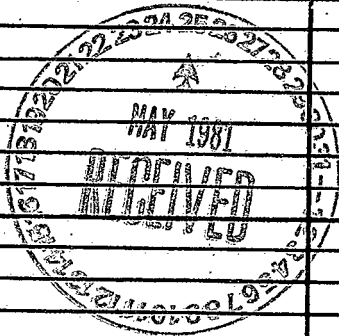

DRILLERS REMARKS:

If well telescopes please sketch and show depths.

GROUND LEVEL

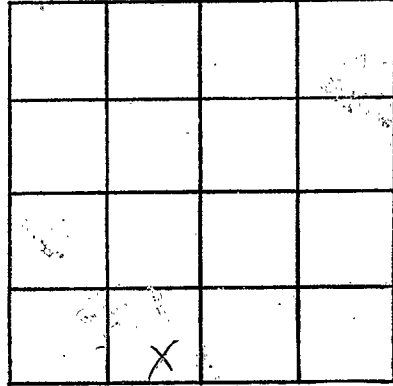

SECTION 17

Please indicate well location X.

ADDITIONAL INFORMATION

If more than one screen,  
show locations of each on sketch.