

Bureau of Land and Water Resources

Southport Mall

P.O. Box 10631

Jackson, Mississippi 39209

WATER WELL DRILLERS LOG

0038

CODED

Sunflower

~~BUNNAR~~ Sunflower  
 J 41  
 2-7-81

2/7 81  
 date well completed

Dyer  
 firm name

Soliton  
 county well located

LANDOWNER:  
 CARLOSS LYON

Shaw MS.  
 (mailing address)

WELL LOCATION:  
 sec 30 T 200 S R 5 E W 6  
 5 miles S of Shaw  
 (distance) (direction) (nearest town)


WELL PURPOSE:  
 (home, irrigation, municipal, industrial)

WELL COMPLETION DATA:

- (1) diameter (inches) 10"
- (2) total depth (feet) 103'
- (3) static water level (feet) 22' below top of ground.
- (4) casing Steel, 103' (material) (depth)  
 10" (size) if telescopic see back.
- (5) screen 40' (length), 63' (depth to top)  
 10" (size) Steel (material)
- (6) pump 10 (HP), 1200 (yield gpm)  
 electric (type power)
- (7) electric log (yes or no)
- (8) how well bottom plugged plate

description of formations encountered	from	to
Clay	0	38
Fine Sand	38	45
Sand	45	55
Sand & gravel	55	103

CODED

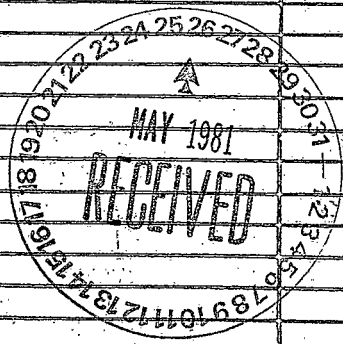

DRILLERS REMARKS:

see 30

