

Bureau of Land and Water Resources
 Southport Mall
 P.O. Box 10631

Jackson, Mississippi 39209

WATER WELL DRILLERS LOG Sunflower

0038
CODED

BOLLAR
J42
2-6-81

SUNFLOWER

2/6/ 19 81
 date well completed

Dyer
 firm name

Bobior
 county well located

LANDOWNER:
CARLOSS LYON
Shaw, MS.
 (mailing address)

description of formations encountered	depth	
	from	to
<u>L'ly</u>	<u>0</u>	<u>28</u>
<u>Fine sand</u>	<u>28</u>	<u>40</u>
<u>Sand</u>	<u>40</u>	<u>103</u>

WELL LOCATION:
 sec. 30 T. 200 S. R. 5 E. W. 5
5 miles S of Shaw
 (distance) (direction) (nearest town)

CODED

WELL PURPOSE:
 (home, irrigation, municipal, industrial)

WELL COMPLETION DATA:

(1) diameter (inches) 12"

(2) total depth (feet) 103

(3) static water level (feet) 22' below top of ground.

(4) casing Steel, 103'
 (material) (depth)

12"
 (size) If telescopic see back.

(5) screen 40', 63'
 (length) (depth to top)


12", Steel
 (size) (material)

(6) pump 40, 2000
 (HP) (yield gpm)

diesel
 (type power)

(7) electric log (yes or no) _____
 (organization running log) _____

(8) how well bottom plugged plate

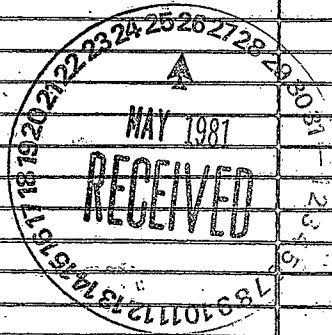

DRILLERS REMARKS:

See 30

