

Sun Flower

~~BOLIVAR~~

J44

2-20-80

MISSISSIPPI
BOARD OF WATER COMMISSIONERS
416 North State Street
Jackson, Mississippi 39201

CODED

WATER WELL DRILLERS LOG

Sun Flower

~~Bolivar~~

2/20

1980

Dyer

date well completed

firm name

county well located

LANDOWNER:

JIMME MUZZI

SHAW MS

(mailing address)

WELL LOCATION:

sec. 32 T. 20 N. R. 5 E. S. 5 W.
6 miles 58 of Shaw
(distance) (direction) (nearest town)

WELL PURPOSE:

(home, irrigation, municipal, industrial)

WELL COMPLETION DATA:

- (1) diameter (inches) 16"
- (2) total depth (feet) 113'
- (3) static water level (feet) 23' below top of ground
- (4) casing (material) Steel (depth) 113'
- 16" if telescope see back. (size)
- (5) screen 40' 73' (length) (depth to top)
- 16" (size) Steel (material)
- (6) pump 60 3000 (HP) (yield gpm)
- Diesel (type power)
- (7) electric log (yes or no)
- (organization running log)
- (8) how well bottom plugged plate


description of formations encountered

from

to

Clay	0	28
Fine Sand	28	38
Sand	38	48
Sand + gravel	48	113

CODED

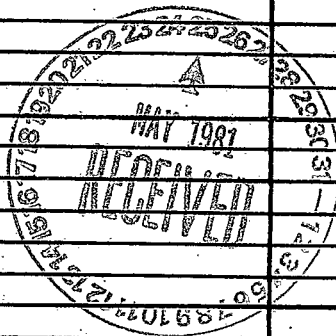

DRILLERS REMARKS:

