

MISSISSIPPI DEPARTMENT OF NATURAL RESOURCES
Bureau of Land and Water Resources
 Southport Mall
 P.O. Box 10631
 Jackson, Mississippi 39209 **CODED**
WATER WELL DRILLERS LOG

SUNFLOWER
J46
6-11-81

6-11- 1981 Dyer Well Sunflower
 date well completed firm name county well located

LANDOWNER:
Pooy Brown
Indianola, MS.
 (mailing address)

description of formations encountered	from	to
clay	0	13
sand	13	53
sand & gravel	53	113

WELL LOCATION:
 sec. 31 T. 20 N. R. 5 E.
 S. (W)
6 miles N of Holly Ridge
 (distance) (direction) (nearest town)

WELL PURPOSE:
 (home, irrigation, municipal, industrial)

WELL COMPLETION DATA:

(1) diameter (inches) 16"

(2) total depth (feet) 113'

(3) static water level (feet) 21' below above top of ground.

(4) casing steel, 113',
 (material) (depth)
16" if telescope see back.
 (size)

(5) screen 40', 73'
 (length) (depth to top)
16", steel
 (size) (material)


(6) pump 60 3000
 (HP) (yield gpm)
electric
 (type power)

(7) electric log _____
 (yes or no)

 (organization running log)

(8) how well bottom plugged plate


CODED

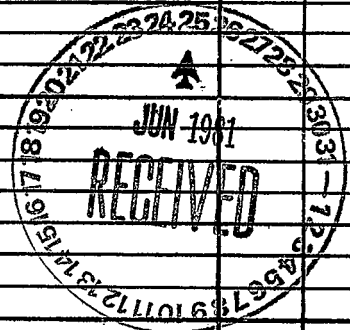

DRILLERS REMARKS:

If well telescopes please sketch and show depths.

GROUND LEVEL

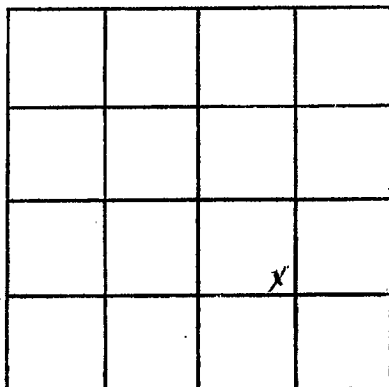

SECTION 31

Please indicate well location X.

ADDITIONAL INFORMATION

If more than one screen,
show locations of each on sketch.