

MISSISSIPPI DEPARTMENT OF NATURAL RESOURCES
Bureau of Land and Water Resources
 Southport Mall
 P.O. Box 10631
 Jackson, Mississippi 39209
WATER WELL DRILLERS LOG

CODED

Sunflower
J 47
6-23-81

6/23/81 19
 date well completed

Superwell Drilling Sunflower
 firm name

county well located

LANDOWNER: Charles Lyons

description of formations encountered

from

to

(mailing address)

WELL LOCATION:

sec. 29 T 20 N R 5 E
5 miles N of INDIANOLA
 (distance) (direction) (nearest town)

WELL PURPOSE:

(home, irrigation, municipal, industrial)

WELL COMPLETION DATA:

- (1) diameter (inches) 12
- (2) total depth (feet) 103
- (3) static water level (feet) 20 below above top of ground.
- (4) casing Steel
 (material) (depth)
12 (size) if telescope see back.
- (5) screen 40'
 (length) (depth to top)
12 (size) (material)
- (6) pump 12 2000
 (HP) (yield gpm)
Diesel (type power)
- (7) electric log NO
 (yes or no)


(organization running log)

(8) how well bottom plugged Plate

DRILLERS REMARKS:


soil	13	23
soil	23	33
clay	33	43
soil	43	53
sand & gravel	53	63
soil & gravel	63	73
gravel	73	83
sand & gravel	83	93
sand & gravel	93	103

CODED

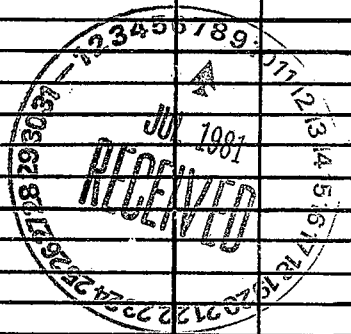

If well telescopes please sketch and show depths.

GROUND LEVEL

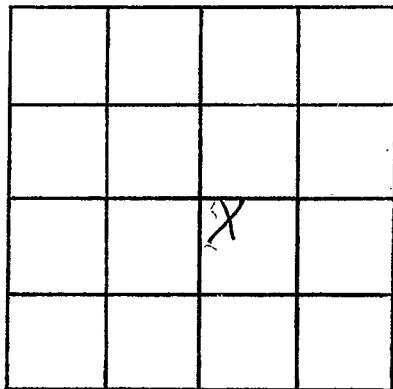

SECTION 29

Please indicate well location X.

ADDITIONAL INFORMATION

If more than one screen,
show locations of each on sketch.