

SUNFLOWER

MISSISSIPPI DEPARTMENT OF NATURAL RESOURCES

Bureau of Land and Water Resources

Southport Mall

P.O. Box 10631

Jackson, Mississippi 39209

WATER WELL DRILLERS LOG

CODED

SUNFLOWER

BOLTVAR

CL-1879

J 48

5-15-81

5-15-81 19 LAYNE - CENTRAL COMPANY firm name

date well completed county well located

LANDOWNER:

Max Hodges, Jr.

Shaw, MS

(mailing address)

description of formations encountered	from	to
clay	0	14
fine sand	14	22
coarse sand	22	42
coarse sand -Pea gravel	42	52
coarse sand - Pea gravel	52	62
coarse sand - Pea gravel	62	82
coarse sand - Pea gravel	82	92
coarse sand - Pea gravel	92	102
coarse sand & gravel	102	112

WELL LOCATION:

sec 24 T 26 N R 5 E

7 miles N of TOSDANSVILLE

(distance) (direction) (nearest town)

WELL PURPOSE: irrigation

(home, irrigation, municipal, industrial)

WELL COMPLETION DATA:

(1) diameter (inches) 32"

(2) total depth (feet) 112'

(3) static water level (feet) 19'3" below above top of ground.

(4) casing steel 62' (material) (depth) 16" (size) If telescope see back.

(5) screen 50 62 (length) (depth to top) 16" (size) (material) st. steel

(6) pump 60 2,500 (HP) (yield gpm) Diesel (type power)

(7) electric log No (yes or no)

(organization running log)

(8) how well bottom plugged St. Plate

CODED

DEPT. OF NATURAL RESOURCES
BUREAU OF LAND & WATER RESOURCES


OCT 20 1981

RECEIVED

DRILLERS REMARKS:

If well telescopes please sketch and show depths.

GROUND LEVEL

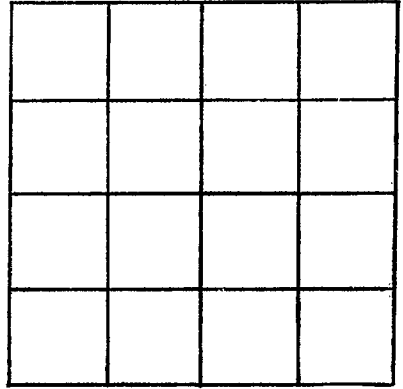

SECTION _____

Please indicate well location X.

ADDITIONAL INFORMATION

If more than one screen,
show locations of each on sketch.