

MISSISSIPPI DEPARTMENT OF NATURAL RESOURCES

Bureau of Land and Water Resources

Southport Mall

P.O. Box 10631

Jackson, Mississippi 39209

WATER WELL DRILLERS LOG

plan for pump
& gpm
10/16/81

CODED

SUNFLOWER

J 49

7-25-81

July 25, 1981
date well completed

Leary's Well & Pump
firm name

Sunflower
county well located

LANDOWNER: Williams Pitts

description of formations encountered

from

to

Indianola Mo.
(mailing address)

CLAY 0' 20'
Coarse SAND 20' 25'
Coarse GRAVEL 85' 100'

WELL LOCATION:

sec. 26 T. 20 N. R. 5 E
7 miles SE of Sharon
(distance) (direction) (nearest town)

WELL PURPOSE:

(home, irrigation, municipal, industrial)

WELL COMPLETION DATA:

- (1) diameter (inches) 10"
- (2) total depth (feet) 100'
- (3) static water level (feet) 20 below above top of ground.
- (4) casing Steel, 60'
(material) (depth)

(size) if telescope see back.

- (5) screen 40', 60'
(length) (depth to top)
- 10", Steel
(size) (material)

- (6) pump NO, 700
(HP) (yield gpm)

(type power)

- (7) electric log NO
(yes or no)

(organization running log)

- (8) how well bottom plugged Steel Plate

DRILLERS REMARKS:

CODED


DEPT. OF NATURAL RESOURCES
BUREAU OF LAND & WATER RESOURCES

OCT 16 1981

RECEIVED

If well telescopes please sketch and show depths.

GROUND LEVEL

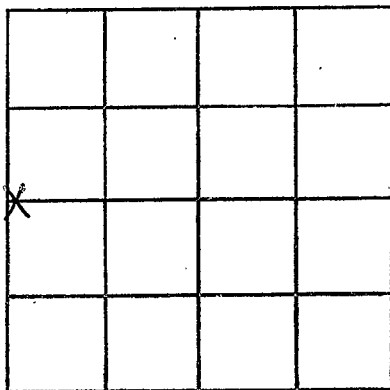

SECTION 26

Please indicate well location X.

ADDITIONAL INFORMATION

If more than one screen,
show locations of each on sketch.