

MISSISSIPPI DEPARTMENT OF NATURAL RESOURCES
Bureau of Land and Water Resources
 Southport Mall
 P.O. Box 10631
 Jackson, Mississippi 39209
WATER WELL DRILLERS LOG

CODED

Sunflower
Q 57
413/82

4-7 19 82 Dyer Well Sunflower
 date well completed firm name county well located

LANDOWNER: Vince Muzzi
 (mailing address)
 WELL LOCATION:
 sec 28 T 20 N R 5 E
6 miles SW of Shaw
 (distance) (direction) (nearest town)

description of formations encountered	from	to
<u>Clay</u>	<u>0</u>	<u>12</u>
<u>Thin Sand</u>	<u>12</u>	<u>20</u>
<u>Sand</u>	<u>28</u>	<u>40</u>
<u>Sand Gravel</u>	<u>40</u>	<u>103</u>

WELL PURPOSE:
 (home, irrigation, municipal, industrial)

WELL COMPLETION DATA:

(1) diameter (inches) 10

(2) total depth (feet) 103

(3) static water level (feet) 15 below above top of ground.

(4) casing Steel, 63,
 (material) (depth)
#10 if telescope see back.
 (size)

(5) screen 46,
 (length) (depth to top)
10, Mild Steel
 (size) (material)

(6) pump 10 600
 (HP) (yield gpm)
electric
 (type power)

(7) electric log No
 (yes or no)
 (organization running log)

(8) how well bottom plugged Plate

DRILLERS REMARKS:


DEPT. OF NATURAL RESOURCES
 BUREAU OF LAND & WATER RESOURCES

JUN 30 1982

RECEIVED

If well telescopes please sketch and show depths.

GROUND LEVEL

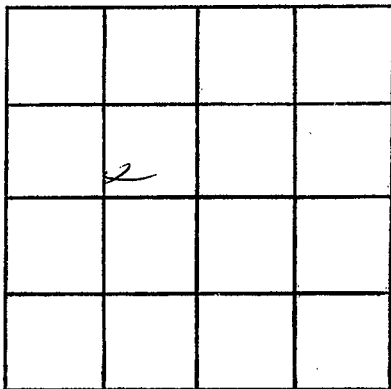

SECTION 28

Please indicate well location X.

ADDITIONAL INFORMATION

If more than one screen, show locations of each on sketch.