

MISSISSIPPI DEPARTMENT OF NATURAL RESOURCES

Bureau of Land and Water Resources

Southport Mall

P.O. Box 10631

CODED

Jackson, Mississippi 39209

WATER WELL DRILLERS LOG

SUNFLOWER
J 55
4/83

date well completed 19 Dyer well firm name Sunflower county well located

LANDOWNER: Willie M. Pitts

description of formations encountered

from

to

II 2

0

210

24

38

34

113

(mailing address)

WELL LOCATION:

sec 26 20 R 5 S 5 miles NW of INDIANOLA
 (distance) (direction) (nearest town)

WELL PURPOSE:

(home, irrigation, municipal, industrial)

WELL COMPLETION DATA:

- (1) diameter (inches) 16"
- (2) total depth (feet) 113
- (3) static water level (feet) 24 below above top of ground.
- (4) casing steel, 73 (material), (depth)
- _____ if telescope see back. (size)
- (5) screen 40 (length) (depth to top)
- 16", steel (size) (material)
- (6) pump 80 1800 (HP) (yield gpm)
- diesel (type power)
- (7) electric log no (yes or no)
- _____ (organization running log)
- (8) how well bottom plugged plate

CODED

DEPT. OF NATURAL RESOURCES
 BUREAU OF LAND & WATER RESOURCES


MAY 9 - 1983

RECEIVED

DRILLERS REMARKS:

If well telescopes please sketch and show depths.

GROUND LEVEL

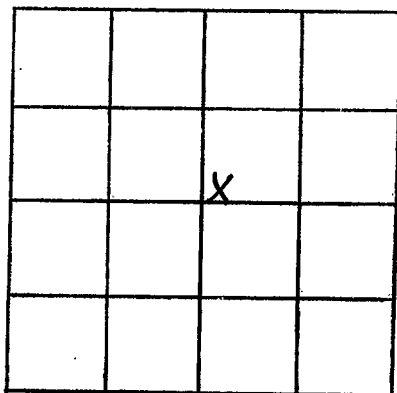

SECTION 26

Please indicate well location X.

ADDITIONAL INFORMATION

If more than one screen,
show locations of each on sketch.