

**MISSISSIPPI DEPARTMENT OF NATURAL RESOURCES**  
**Bureau of Land and Water Resources**  
 Southport Mall  
 P.O. Box 10631  
 Jackson, Mississippi 39209  
**WATER WELL DRILLERS LOG**

**CODED**

12

J56  
 SUNFLOWER Co.  
 2-25-84

February 25, 1984 Irrigation Equip., Inc. Sunflower  
 date well completed firm name county well located

LANDOWNER: P.H. Brown	description of formations encountered	from	to
109 E. Augusta St.			
Indianola, Ms. 38751	Fine Sand	10	75
(mailing address)	Coarse Sand & Gravel	75	115

**WELL LOCATION:**  
 sec. 30 T-20 S R-5 E  
 1.5 miles NE of Frazier  
 (distance) (direction) (nearest town)

**WELL PURPOSE:** Irrigation  
 (home, irrigation, municipal, industrial)

**CODED**

- WELL COMPLETION DATA:**
- (1) diameter (inches) 10"
  - (2) total depth (feet) 115'
  - (3) static water level (feet) 18' below top of ground.
  - (4) casing Steel, 65' (material) (depth)  
 (size) if telescope see back.
  - (5) screen 40', 65' (length) (depth to top)  
 10" Steel (size) (material)
  - (6) pump 40 600 (HP) (yield gpm)  
 Deisel (type power)
  - (7) electric log (yes or no)  
 (organization running log)
  - (8) how well bottom plugged Steel plate

DEPT. OF NATURAL RESOURCES  
 BUREAU OF LAND & WATER RESOURCES


MAR 26 1984

**RECEIVED**

DRILLERS REMARKS:

If well telescopes please sketch and show depths.

GROUND LEVEL

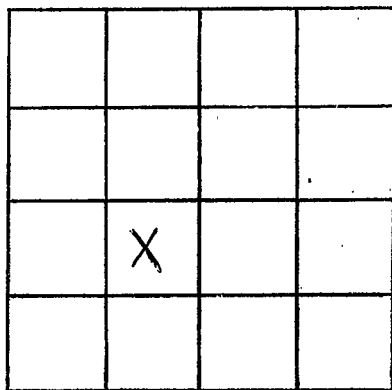

SECTION \_\_\_\_\_

Please indicate well location X.

ADDITIONAL INFORMATION

If more than one screen,  
show locations of each on sketch.