

MISSISSIPPI DEPARTMENT OF NATURAL RESOURCES

Bureau of Land and Water Resources

Southport Mall

P.O. Box 10631

Jackson, Mississippi 39209

WATER WELL DRILLERS LOG

CODED

Print.

SUNFLOWER
 J 57
 84

date well completed 19 Dyer Well firm name SunFlower county well located

LANDOWNER:	description of formations encountered	from	to
<u>Sessions Pleasants.</u>			
<u>Shaw, Miss.</u> (mailing address)	<u>Clay</u>	<u>0</u>	<u>18</u>
	<u>Gravel Sand</u>	<u>18</u>	<u>70</u>
	<u>Sand + Gravel</u>	<u>70</u>	<u>93</u>

WELL LOCATION:
 sec. 7 T. 20 N. R. 5 E.
3 miles East of Shaw
 (distance) (direction) (nearest town)

CODED

WELL PURPOSE: DOM.
 (home, irrigation, municipal, industrial)

- WELL COMPLETION DATA:
- (1) diameter (inches) 16"
 - (2) total depth (feet) 93'
 - (3) static water level (feet) 28 1/2' below top of ground.
 - (4) casing STEEL, 53',
 (material) (depth)
16" If telescope see back.
 (size)
 - (5) screen 40, 53'
 (length) (depth to top)
16", STEEL
 (size) (material)
 - (6) pump 40 (800)
 (HP) (yield gpm)
 - DIES.
 (type power)
 - (7) electric log No
 (yes or no)
No
 (organization running log)

DEPT. OF NATURAL RESOURCES
 BUREAU OF LAND & WATER RESOURCES

JUL - 2 1984


RECEIVED

(8) how well bottom plugged STEEL PLATE.

DRILLERS REMARKS:

If well telescopes please sketch and show depths.

GROUND LEVEL

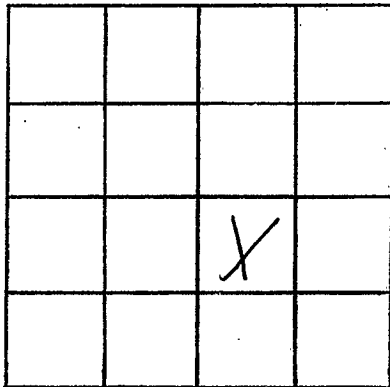

SECTION 7

Please indicate well location X.

ADDITIONAL INFORMATION

If more than one screen,
show locations of each on sketch.