

SUNFLOWER
J 58

MISSISSIPPI DEPARTMENT OF NATURAL RESOURCES
Bureau of Land and Water Resources
Southport Mall
P.O. Box 10631
Jackson, Mississippi 39209
WATER WELL DRILLERS LOG

CODED

6-22-84 19 IRRIGATION Equipment Sunflower
date well completed firm name county well located

LANDOWNER: <u>Seymour Johnson</u>	description of formations encountered	from	to
<u>101 S. Sunflower Ave</u>	<u>Clay</u>	<u>0</u>	<u>30</u>
<u>Indianola, Ms. 39751</u>	<u>gravel / clay</u>	<u>31</u>	<u>40</u>
<u>Pivot (mailing address)</u>	<u>Sand</u>	<u>41</u>	<u>65</u>
WELL LOCATION:	<u>Coarse sand gravel</u>	<u>66</u>	<u>105</u>
sec. <u>33</u> T <u>20</u> N R <u>5</u> E			
<u>8</u> miles <u>NW</u> of <u>Indianola</u>			
(distance) (direction) (nearest town)			
WELL PURPOSE: <u>IRrigation</u> (home, irrigation, municipal, industrial)			
WELL COMPLETION DATA:			
(1) diameter (inches) <u>16"</u>			
(2) total depth (feet) <u>105</u>			
(3) static water level (feet) <u>19</u> below above top of ground.			
(4) casing <u>Steel</u> <u>65'</u> (material) (depth)			
_____ if telescope see back. (size)			
(5) screen <u>40'</u> <u>65'</u> (length) (depth to top)			
<u>1/2"</u> <u>Steel</u> (size) (material)			
(6) pump _____ (HP) (yield gpm)			
<u>Diesel</u> (type power)			
(7) electric log _____ (yes or no)			
_____ (organization running log)			
(8) how well bottom plugged <u>steel plate</u>			
DRILLERS REMARKS:			


CODED

DEPT. OF NATURAL RESOURCES
BUREAU OF LAND & WATER RESOURCES

SEP - 4 1984
RECEIVED

If well telescopes please sketch and show depths.

GROUND LEVEL

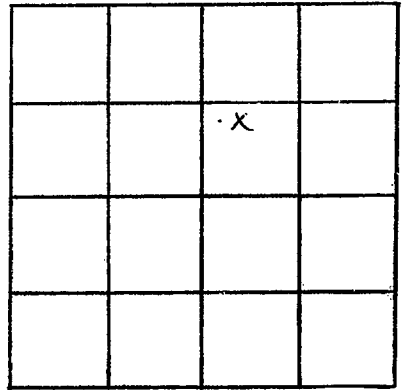

SECTION 33

Please indicate well location X.

ADDITIONAL INFORMATION

If more than one screen, show locations of each on sketch.