

MISSISSIPPI DEPARTMENT OF NATURAL RESOURCES

Bureau of Land and Water Resources

Southport Mall

P.O. Box 10631

Jackson, Mississippi 39209

WATER WELL DRILLERS LOG

CODED

T.E.P.#  
 06794 CMG-04-18-87  
 SUNFLOWER  
 J 61

2-13 1987 date well completed  
 Dyer Well, Inc. firm name  
 Sunflower county well located

LANDOWNER: Mike Thomas  
 Rt. 1, Box 100  
 Shaw, Ms. 38773  
 (mailing address)

description of formations encountered	from to	
Clay	0	50
Sand + Gravel	50	103

WELL LOCATION:  
 sec. 6 T 20N R 5E  
 1 miles East of Shaw  
 (distance) (direction) (nearest town)

WELL PURPOSE: Irrigation  
 (home, irrigation, municipal, industrial)

WELL COMPLETION DATA:

- (1) diameter (inches) 10"
- (2) total depth (feet) 103
- (3) static water level (feet) \_\_\_\_\_ below above top of ground.
- (4) casing steel, 63, (material) (depth)  
 10" (size) If telescope see back.
- (5) screen 40, 50 (length) (depth to top)  
 10", mild steel (size) (material)
- (6) pump 20, 1200 (HP) (yield gpm)  
 Electric (type power)
- (7) electric log No (yes or no)  
 (organization running log)
- (8) how well bottom plugged Plate

CODED

RECEIVED


FEB 19 1987

Department of Natural Resources  
 Bureau of Land & Water Resources

DRILLERS REMARKS:  
 T.E.P.#  
 06794 CMG-04-18-87

If well telescopes please  
sketch and show depths.

GROUND LEVEL

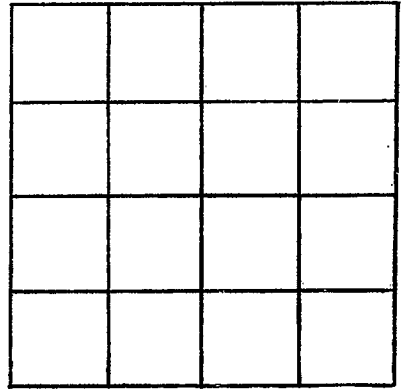

SECTION \_\_\_\_\_

Please indicate well location X.

ADDITIONAL INFORMATION

If more than one screen,  
show locations of each on sketch.