

MISSISSIPPI DEPARTMENT OF NATURAL RESOURCES

Bureau of Land and Water Resources

Southport Mall

P.O. Box 10631

Jackson, Mississippi 39209

WATER WELL DRILLERS LOG

Permit Applied For

SNAPWEX
July 65

date well completed

firm name

county well located

88 Day Well

Sunflower

LANDOWNER:

Margaret Monks

description of formations encountered

from

to

Shaw, Ms. 38773
(mailing address)

Clay	0	28
Fine Sand	28	40
M Sand + Gravel	40	54
Fine Sand	54	65
Sand + Gravel	65	84
Fine Sand	84	100
Sand + Gravel	100	135

WELL LOCATION:

127C sec. 20 T. 20 N R. 5
3 miles S of Shaw
(distance) (direction) (nearest town)

WELL PURPOSE:

Irrigation
(home, irrigation, municipal, industrial)

WELL COMPLETION DATA:

- (1) diameter (inches) 10"
- (2) total depth (feet) 135'
- (3) static water level (feet) _____ below above top of ground.
- (4) casing steel (material), _____ (depth), 10" (size) if telescope see back.
- (5) screen 40 (length), _____ (depth to top), 10 (size), _____ (material)
- (6) pump 15 (HP), _____ (yield gpm), Elec (type power)
- (7) electric log No (yes or no), None (organization running log)
- (8) how well bottom plugged Plate

RECEIVED


MAY 02 1965

Department of Natural Resources
Bureau of Land and Water Resources

DRILLERS REMARKS:

If well telescopes please sketch and show depths.

GROUND LEVEL

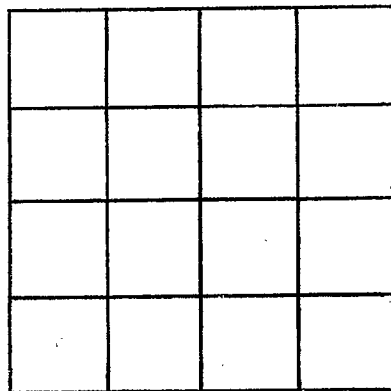

SECTION _____

Please indicate well location X.

ADDITIONAL INFORMATION

If more than one screen,
show locations of each on sketch.